


TOTAL SF AVAILABLE -12,500 SF


OFFICE - 1,276 SF

WAREHOUSE SF - 11,224 SF

[Click to access 3D model](#)

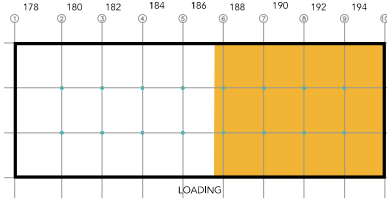

Key Plan

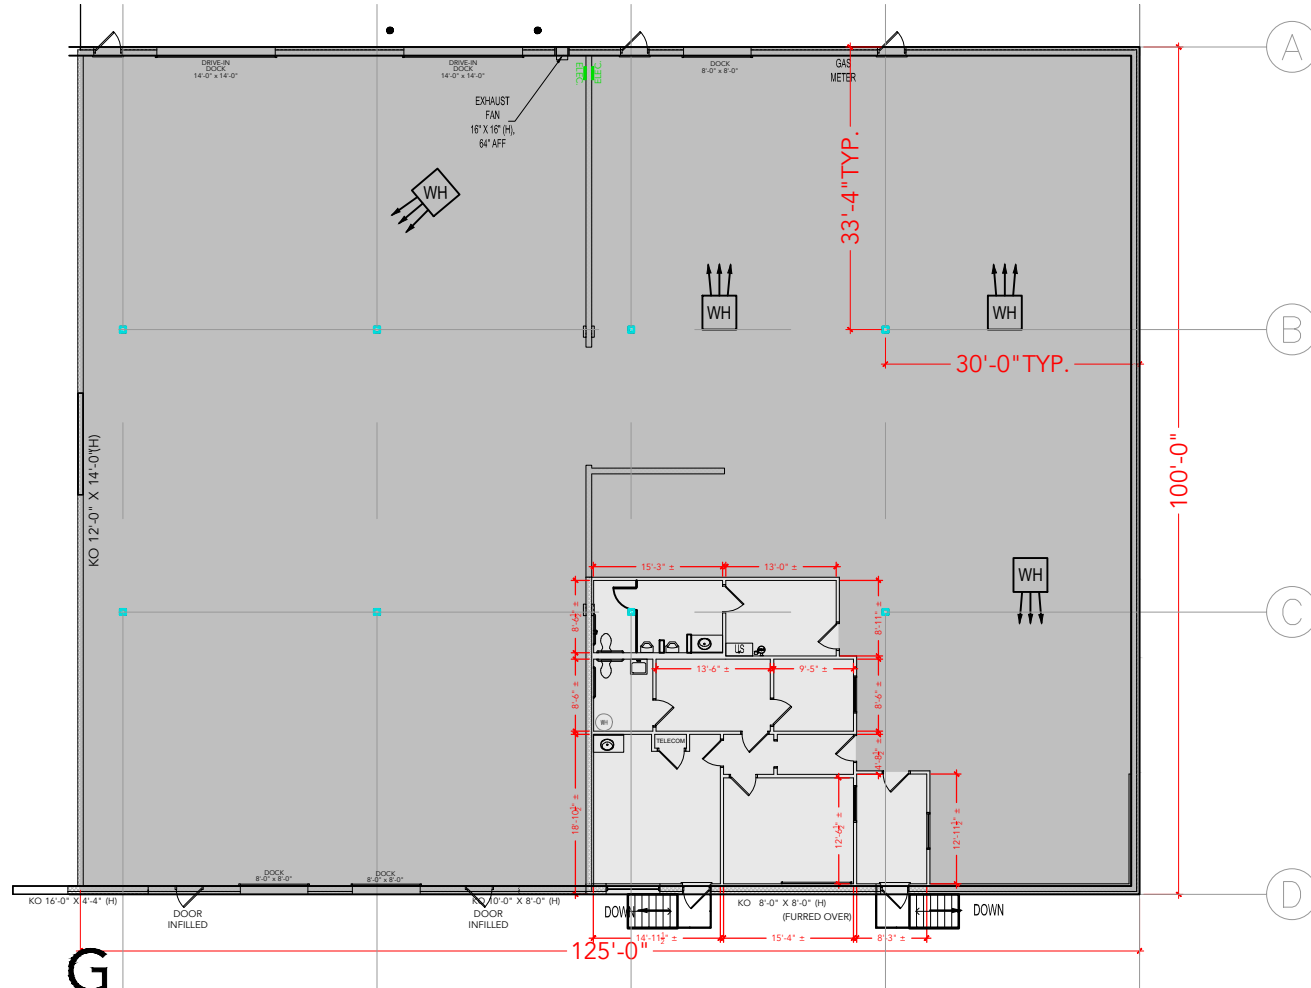

Floor Plan