


Key Plan

TOTAL SF AVAILABLE - 1,050 SF

OFFICE - 0,000 SF

WAREHOUSE - 1,050 SF

[Click to access 3D model](#)

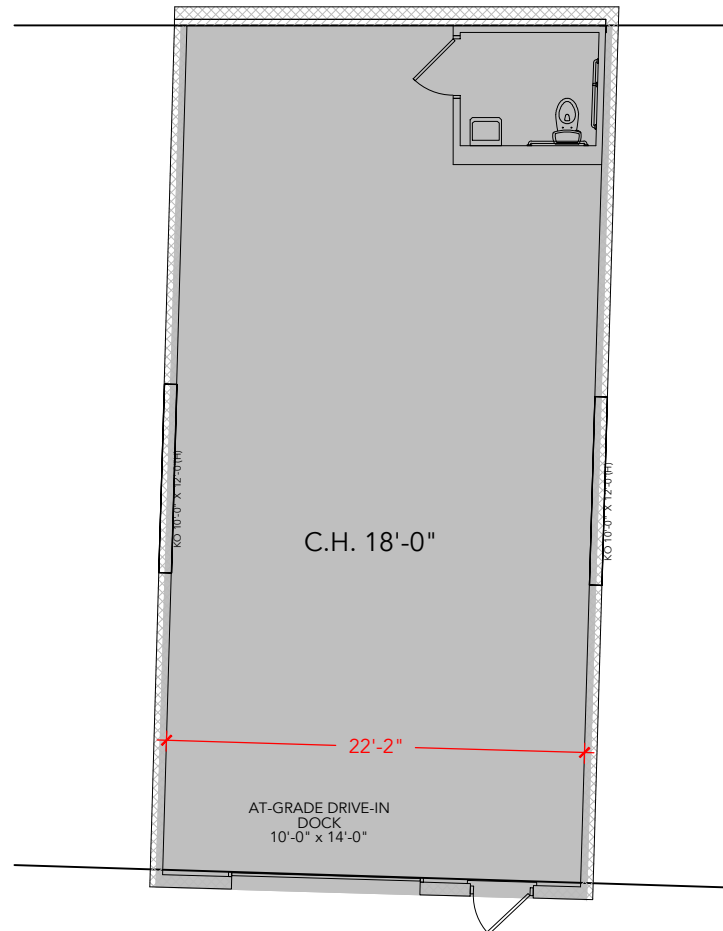

Floor Plan