


TOTAL SF AVAILABLE - 3,000 SF


OFFICE - 1,781 SF

WAREHOUSE - 1,219 SF

[Click to access 3D model](#)

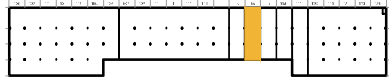

Key Plan

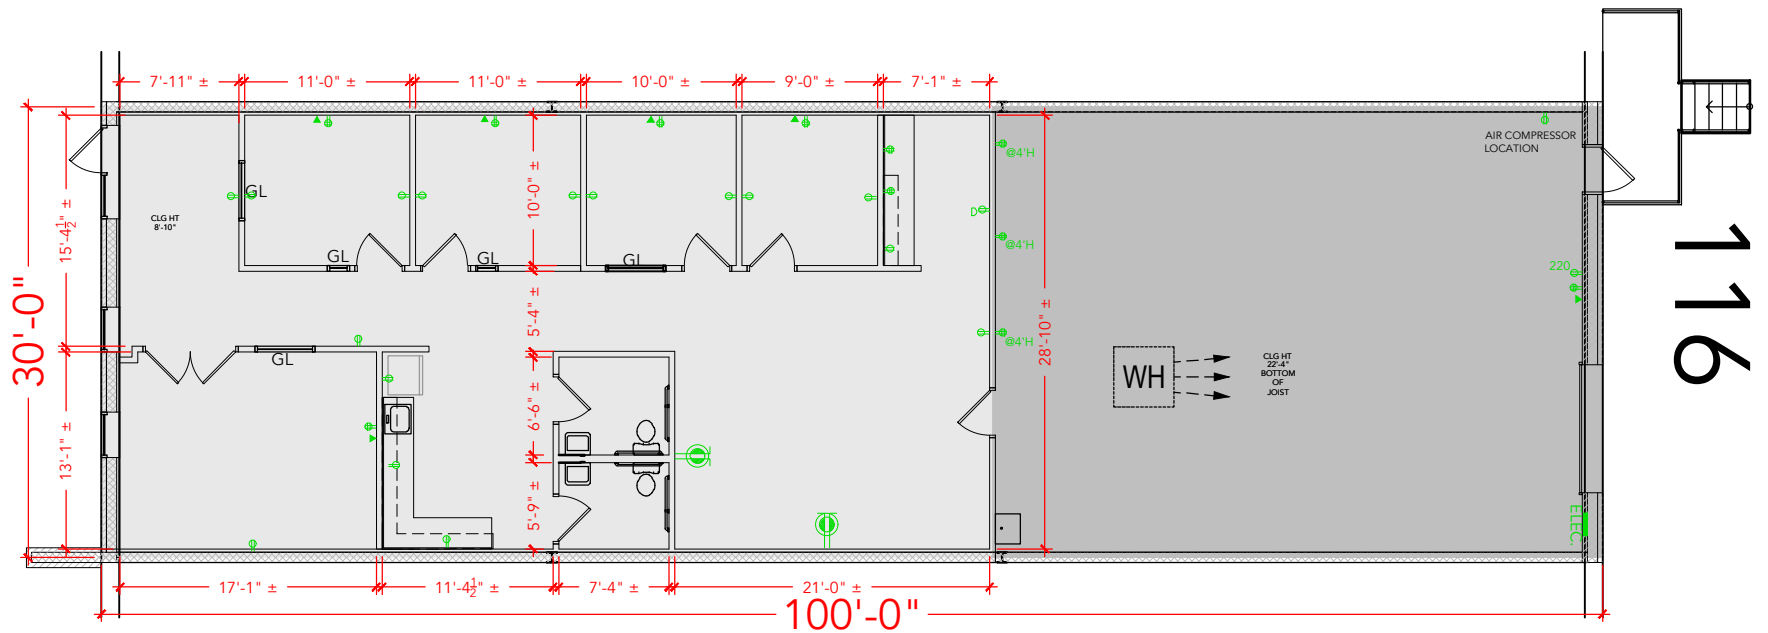

Floor Plan