


**TOTAL SF AVAILABLE - 8,800 SF**


**OFFICE - 1,614 SF**

**WAREHOUSE SF - 7,186 SF**

[Click to access 3D model](#)

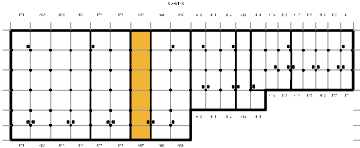

Key Plan

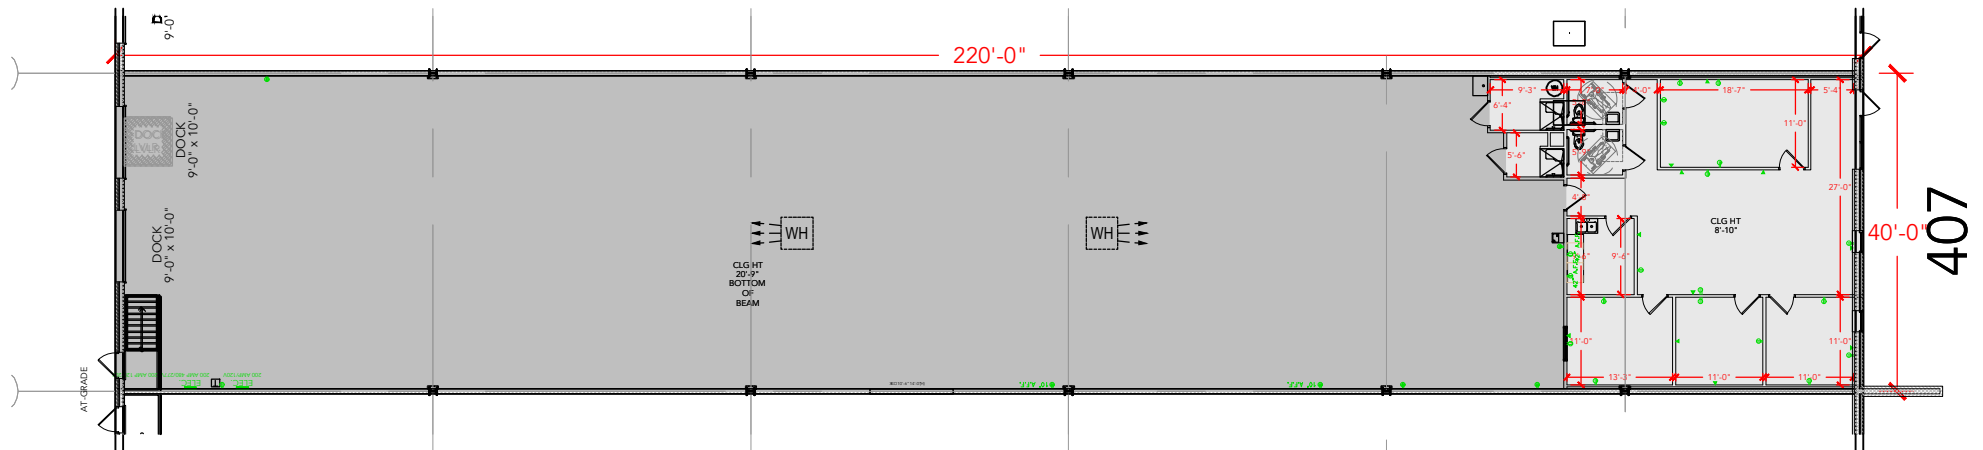

Floor Plan