


TOTAL SF AVAILABLE -1,500 SF


OFFICE - 638 SF

WAREHOUSE - 862 SF

[Click to access 3D model](#)

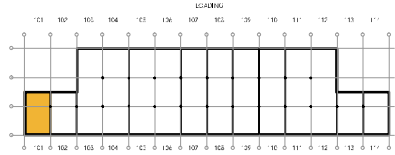

Key Plan

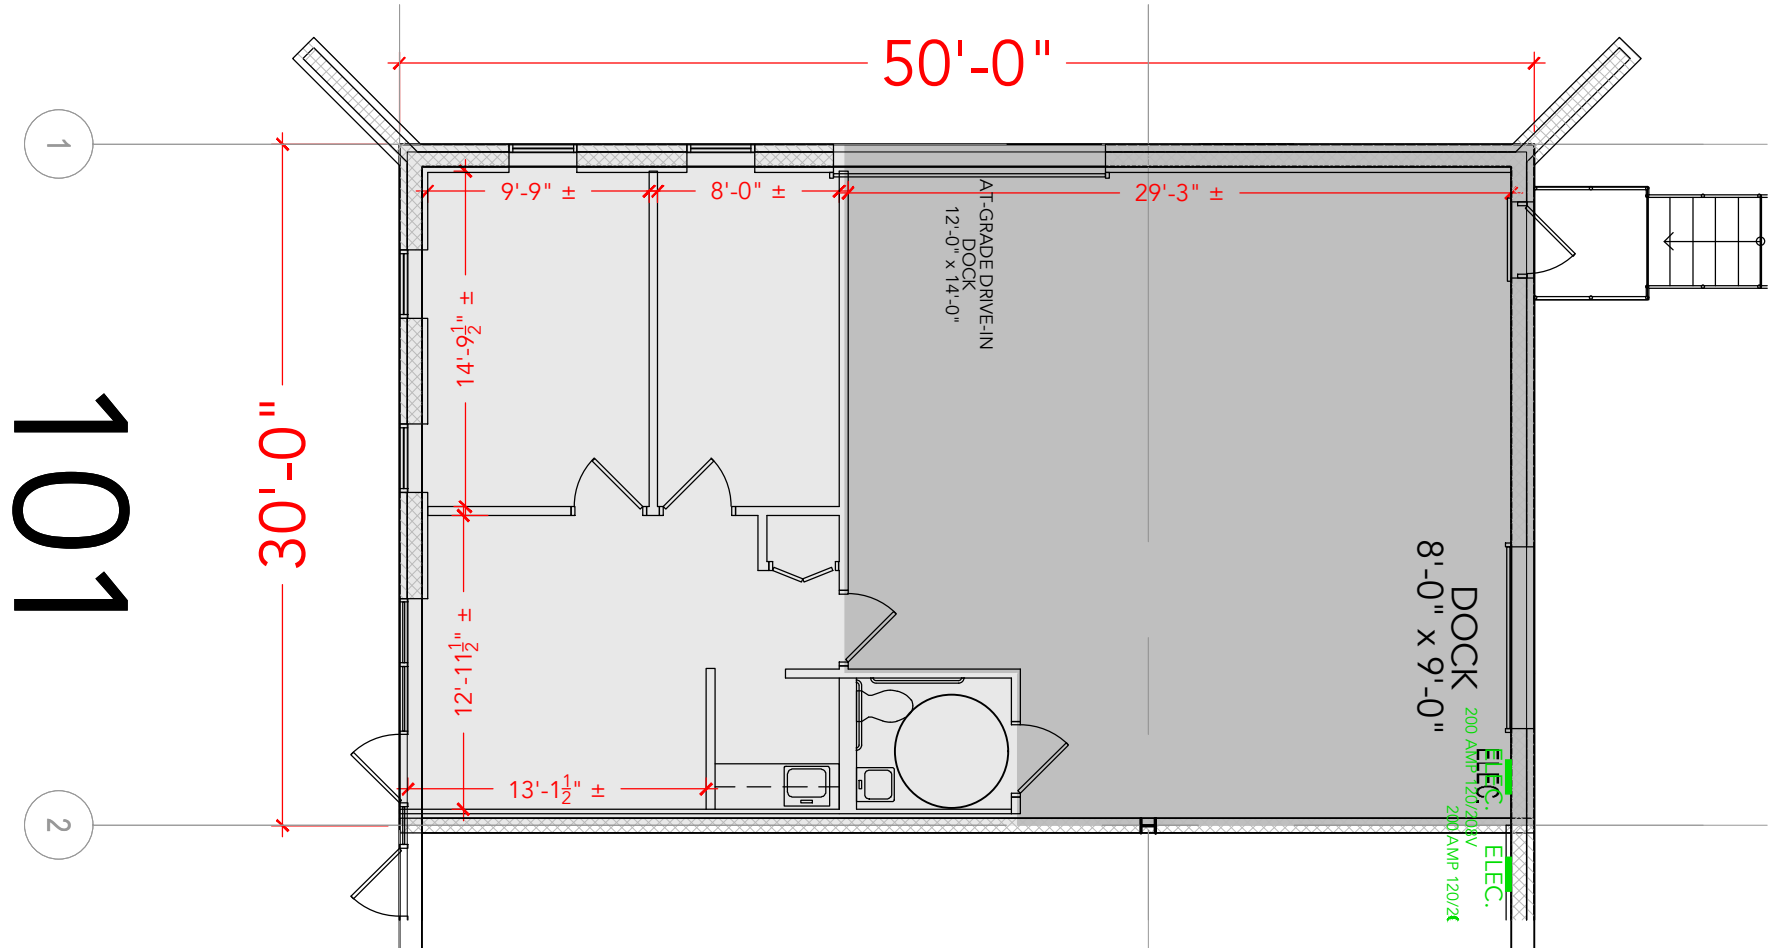

Floor Plan