

TOTAL SF AVAILABLE - 17,540 SF


OFFICE - 17,540 SF

WAREHOUSE - 0,000 SF

[Click to access 3D model](#)



Key Plan

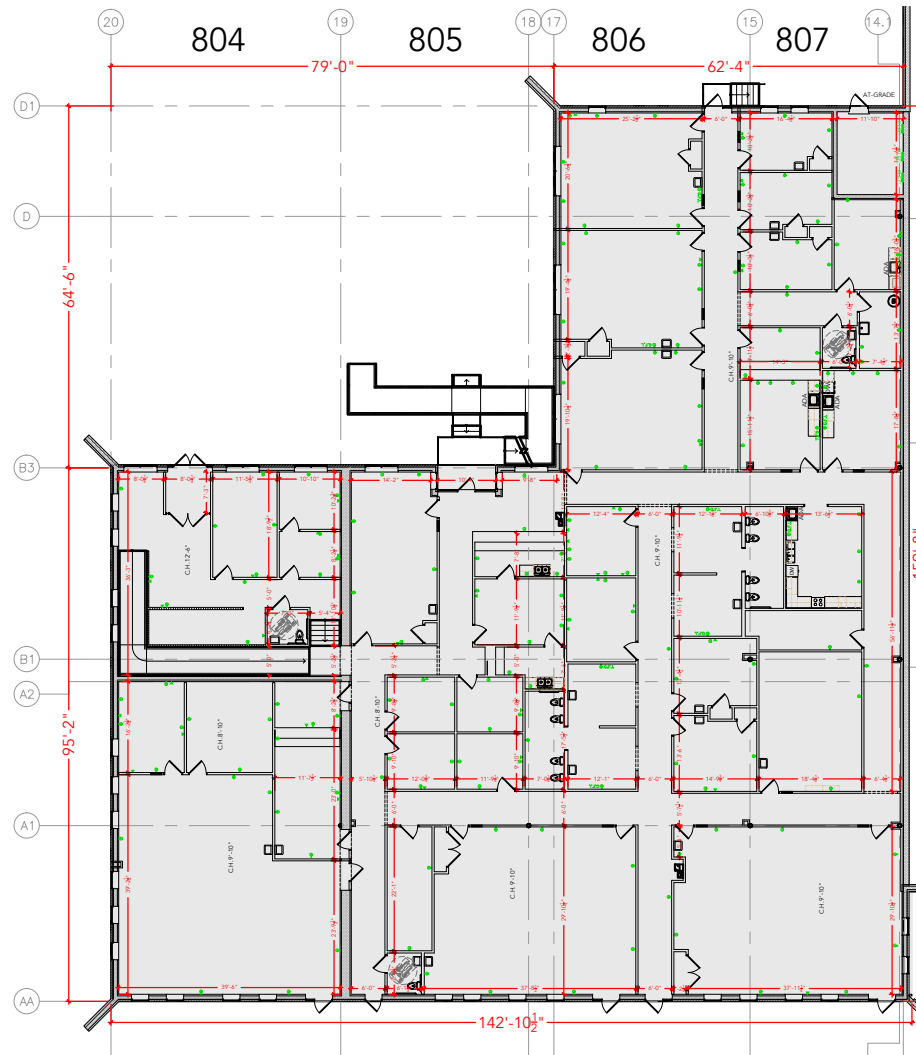

Floor Plan