



TOTAL SF AVAILABLE - 10,140 SF

OFFICE - 370 SF
WAREHOUSE SF - 9,770 SF

[Click to access 3D model](#)

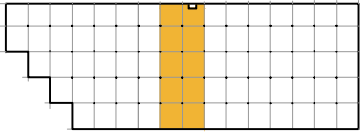

Key Plan

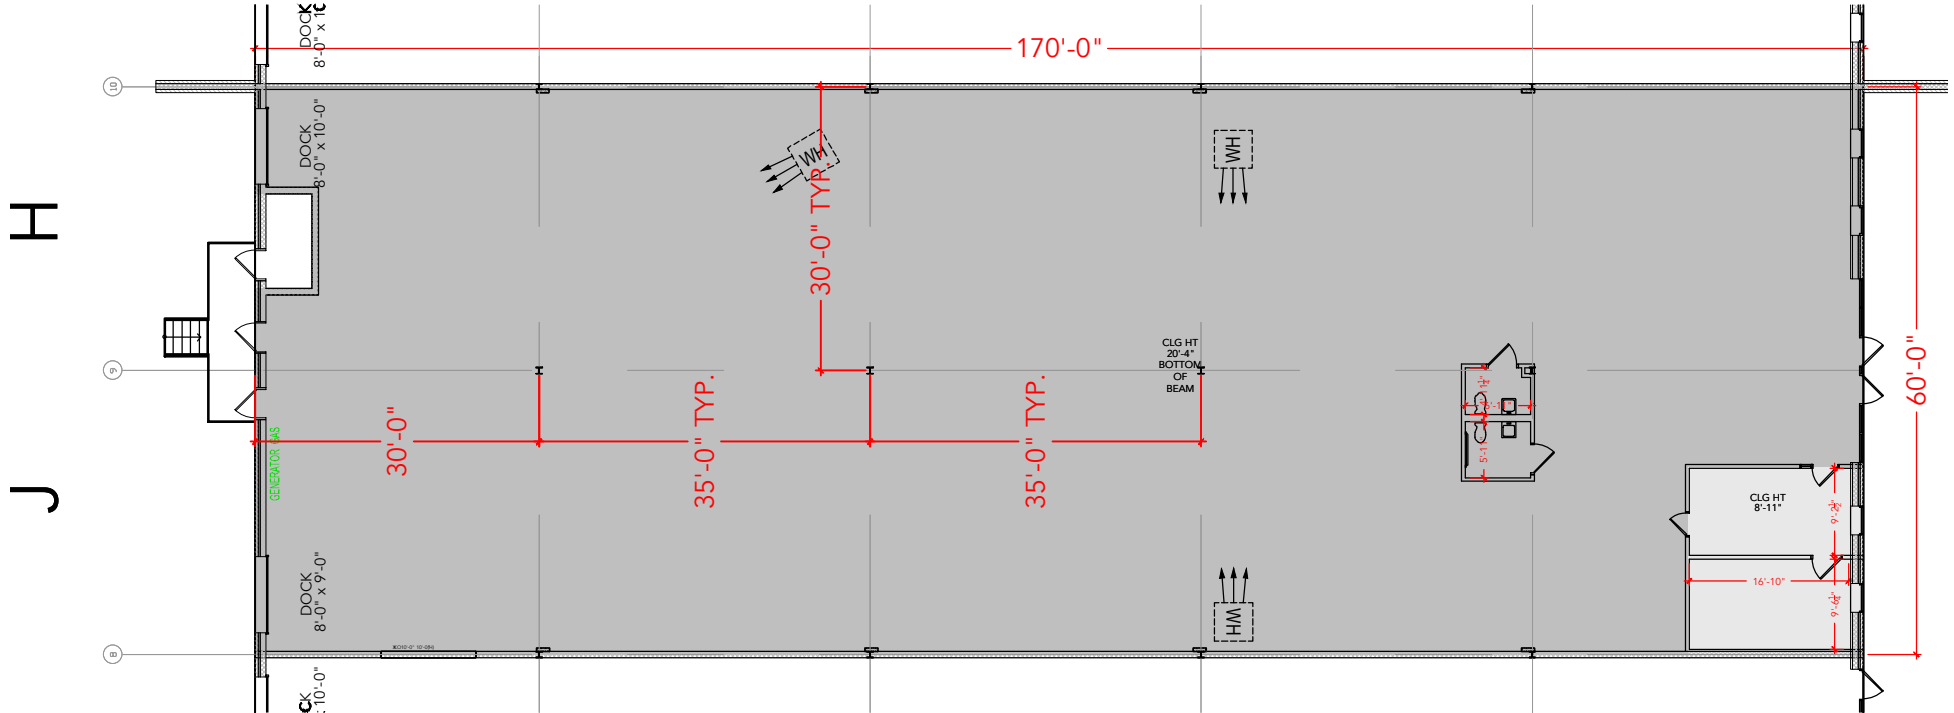

Floor Plan