



TOTAL SF AVAILABLE - 4,050 SF

OFFICE - 2,354 SF
WAREHOUSE - 1,696 SF

[Click to access 3D model](#)

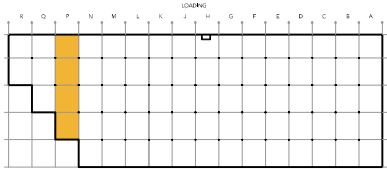

Key Plan

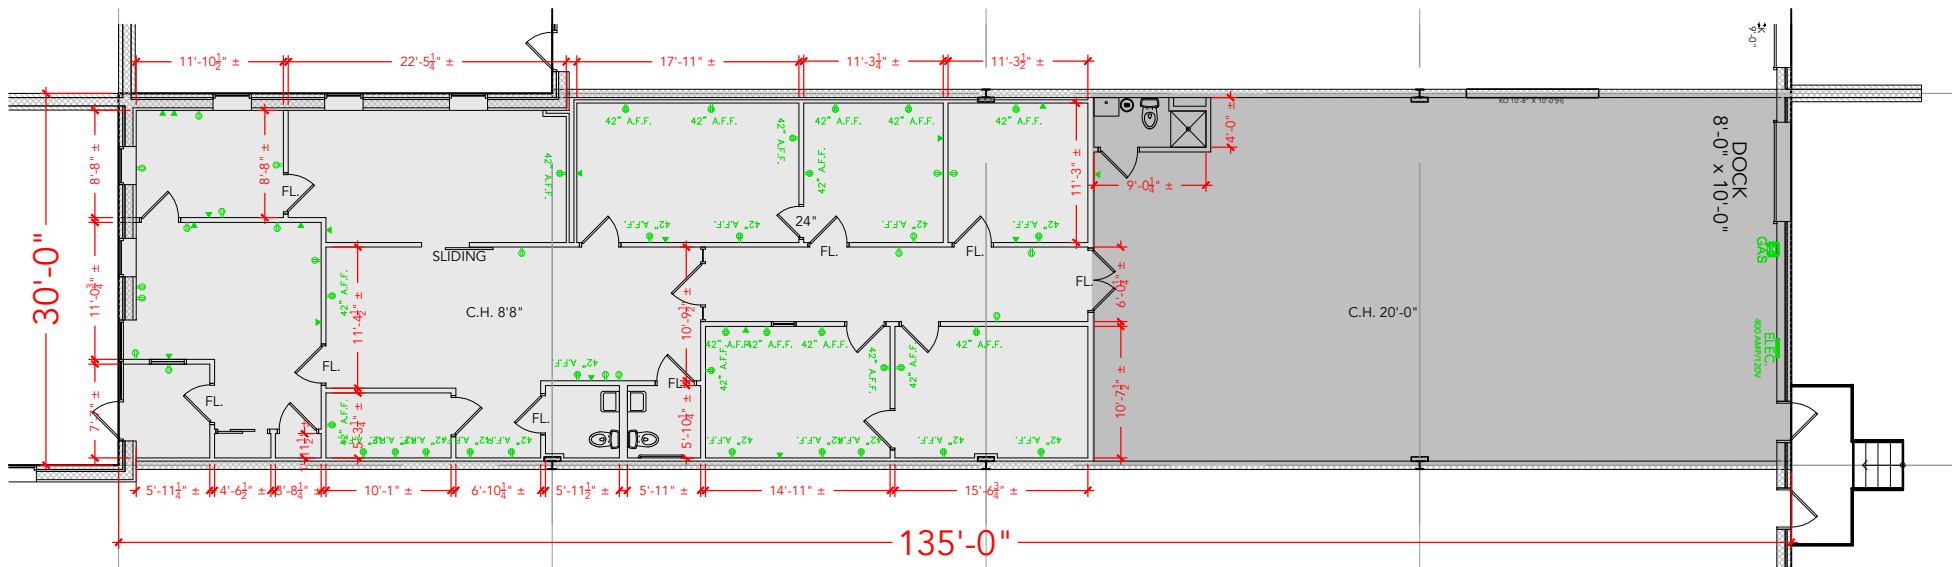

Floor Plan