


LOADING

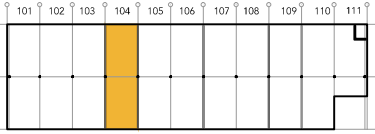


TOTAL SF AVAILABLE - 2,000 SF

OFFICE SF - 1,178 SF

WAREHOUSE SF - 822 SF

[Click to access 3D model](#)

Key Plan

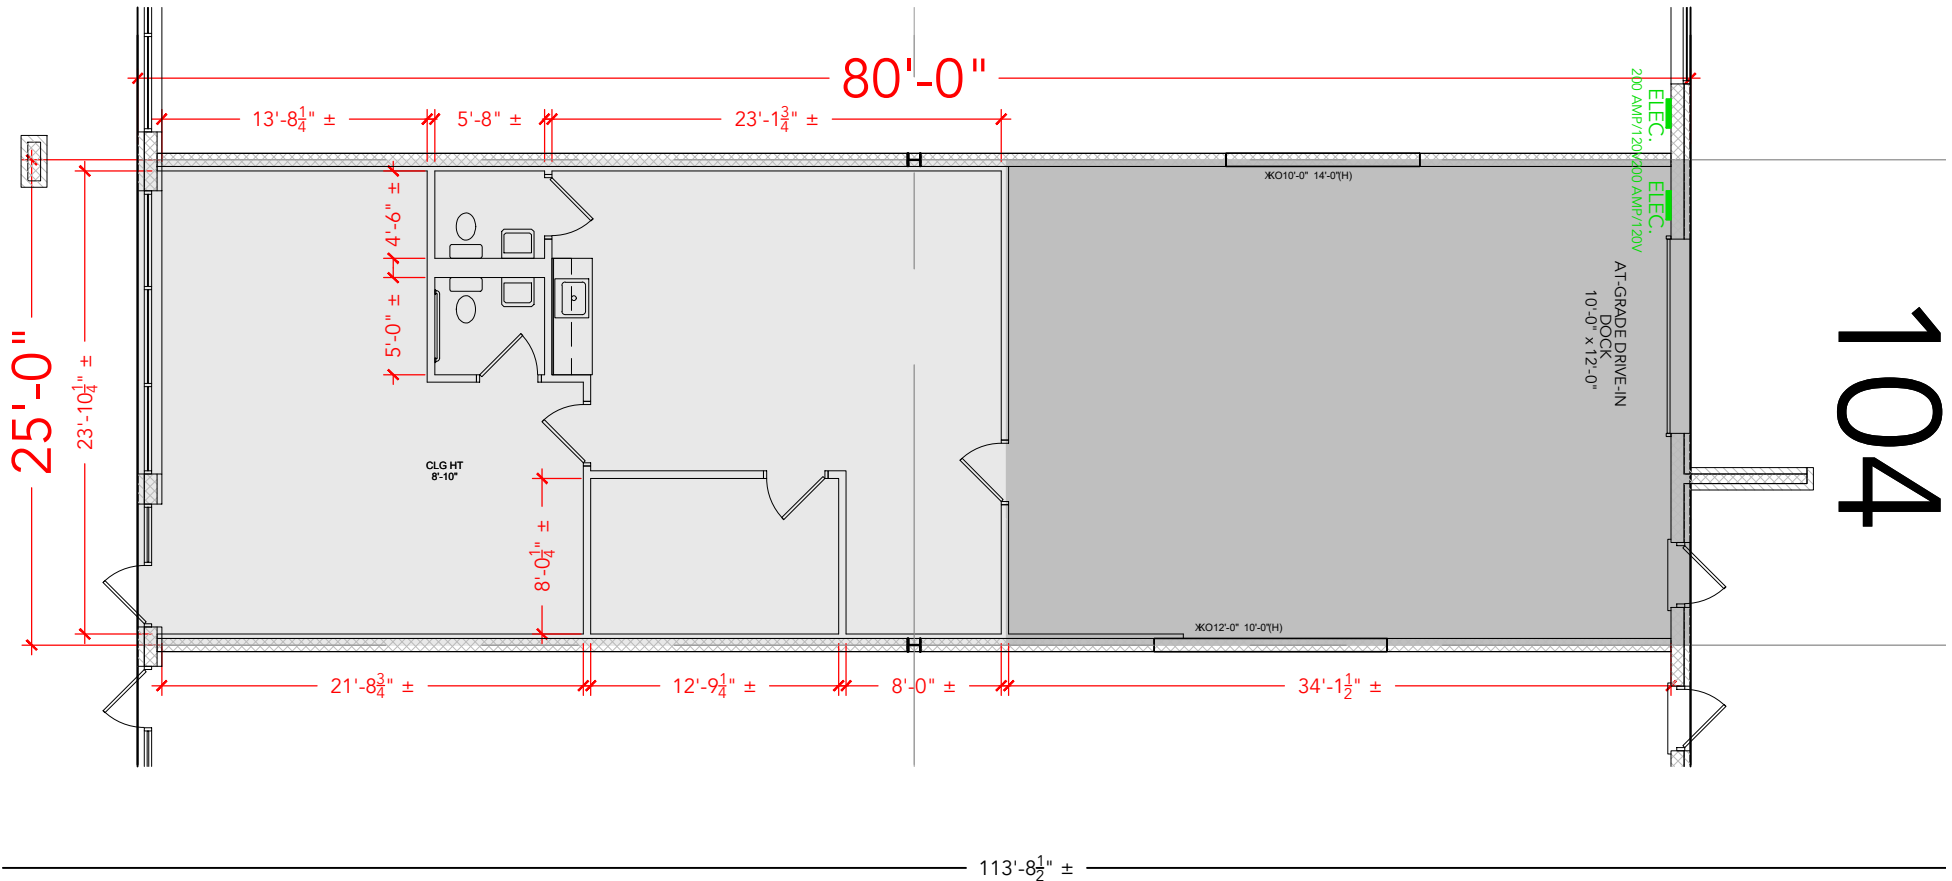

Floor Plan