


TOTAL SF AVAILABLE - 2,000 SF


OFFICE - 734 SF

WAREHOUSE - 1,266 SF

[Click to access CADD file](#)

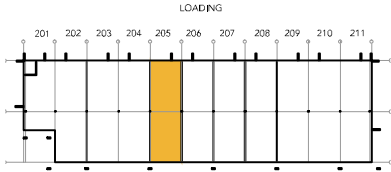

Key Plan

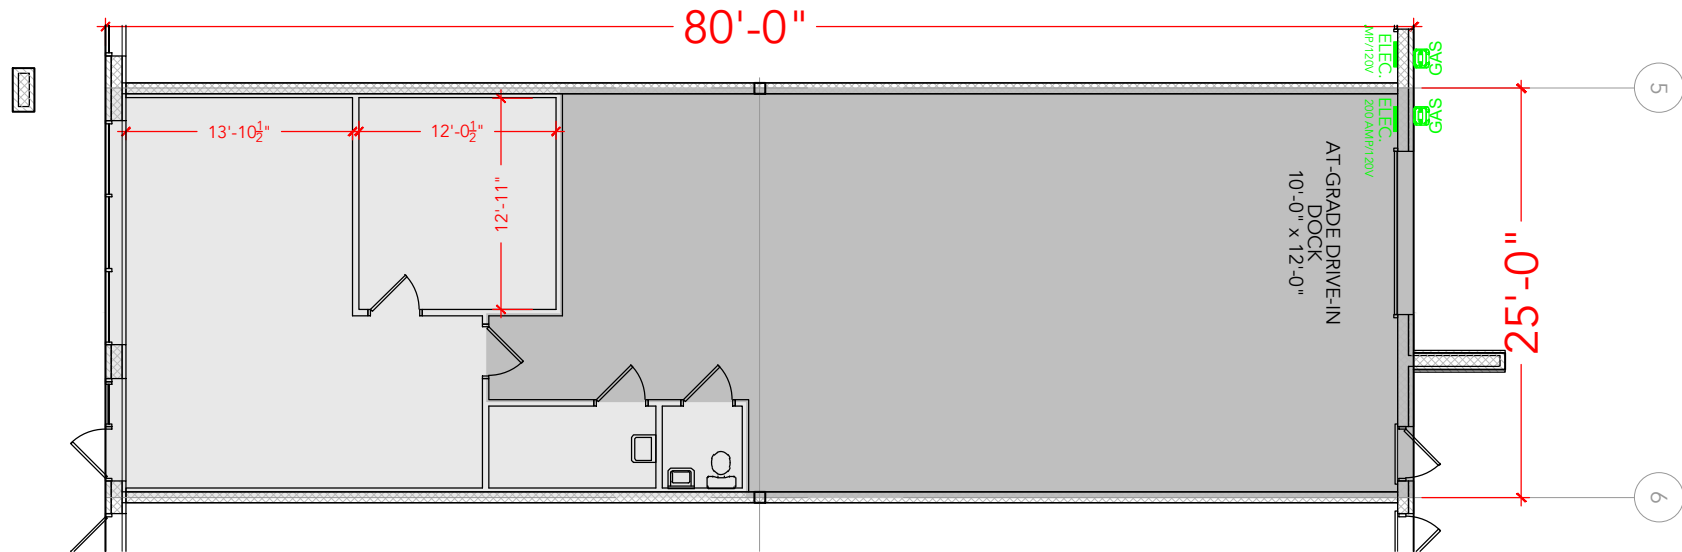

205

Floor Plan