



TOTAL SF AVAILABLE -2,550 SF

OFFICE - 0,000 SF  
WAREHOUSE - 2,550 SF

[Click to access 3D model](#)

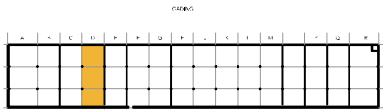

Key Plan

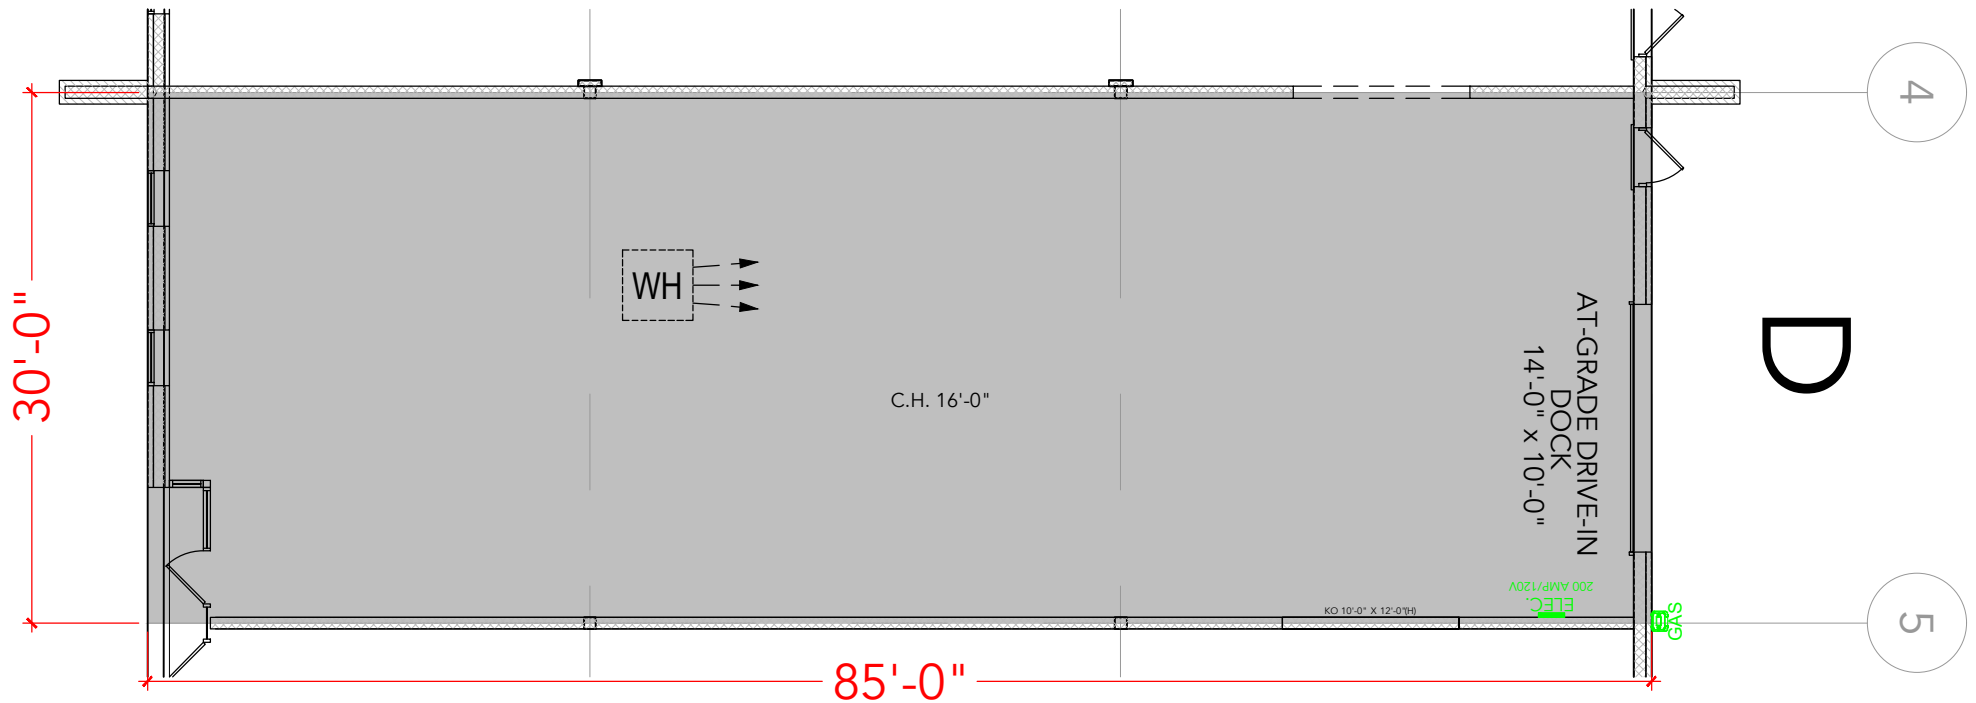

Floor Plan