


TOTAL SF AVAILABLE - 3,323 SF

OFFICE - 1,448 SF
WAREHOUSE - 1,875 SF

[Click to access 3D model](#)

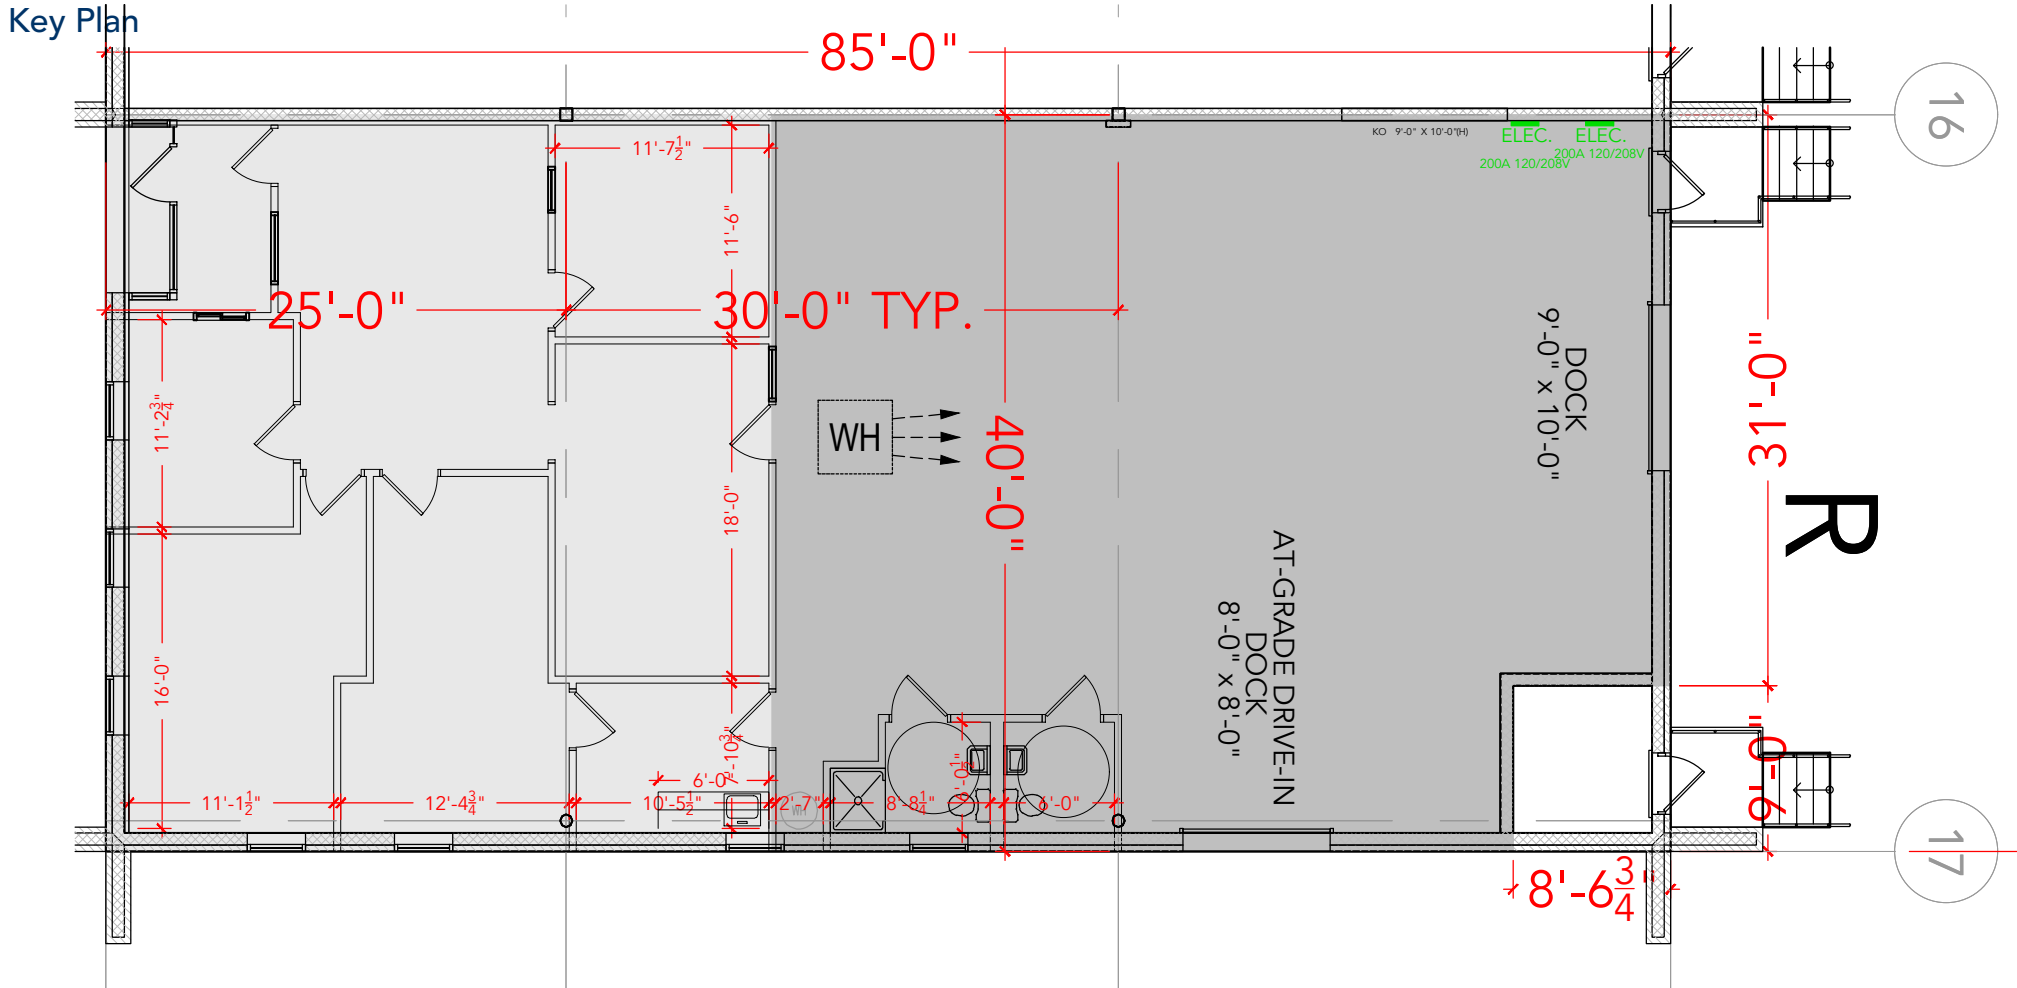

Floor Plan