


TOTAL SF AVAILABLE - 12,500 SF


OFFICE - 549 SF

WAREHOUSE - 11,951 SF

[Click to access 3D model](#)

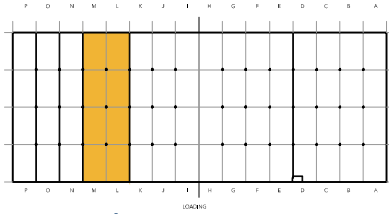

Key Plan

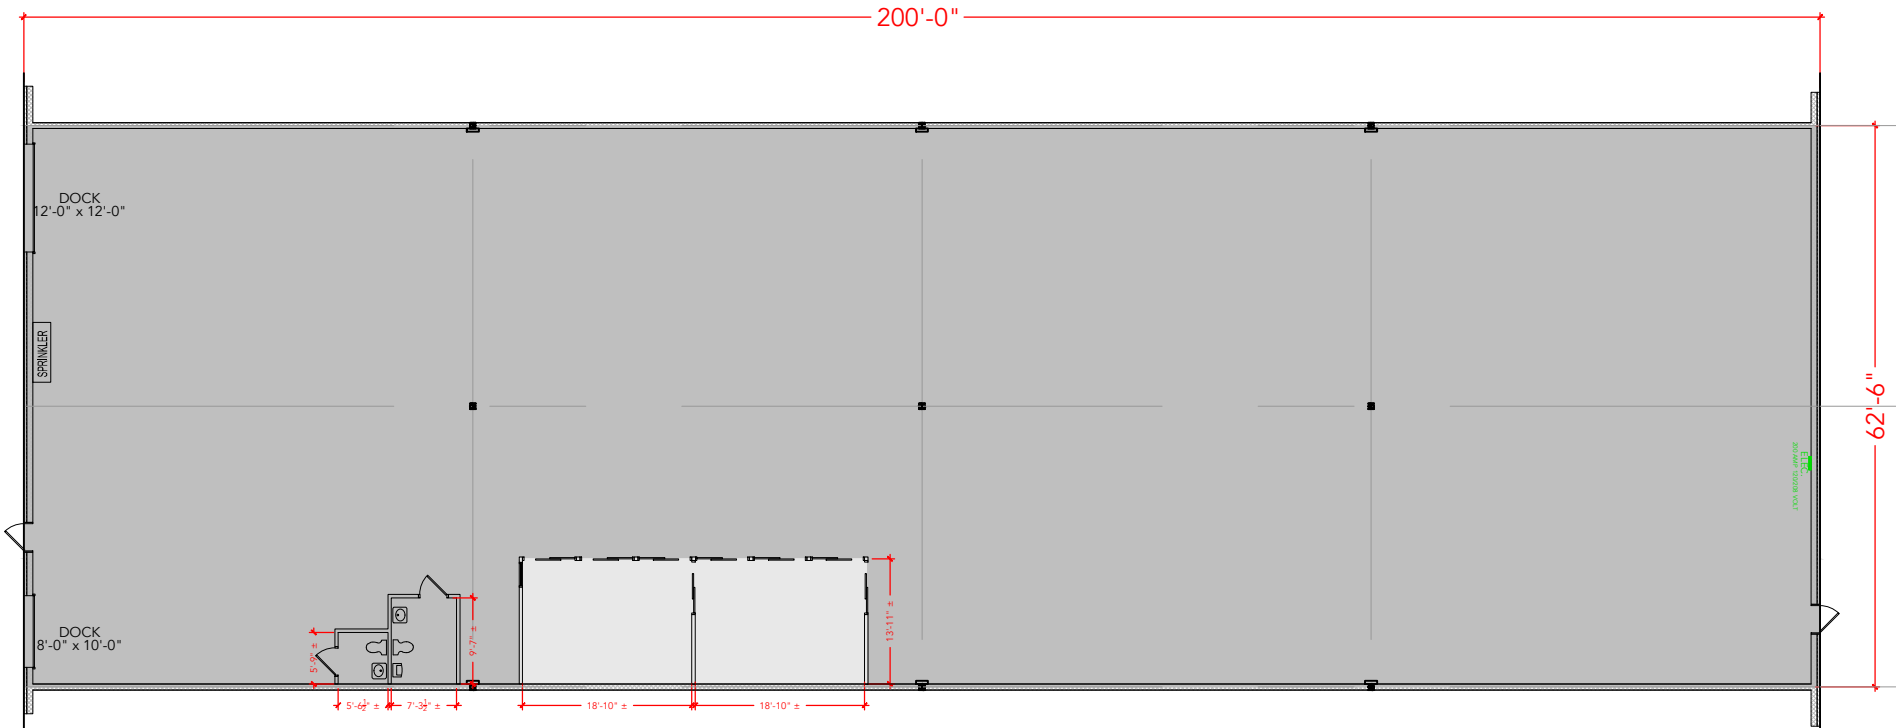

Floor Plan