


TOTAL SF AVAILABLE -9,450 SF


OFFICE - 1,333 SF

WAREHOUSE SF - 8,117 SF

[Click to access 3D model](#)

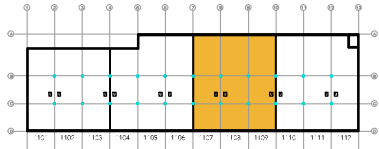

Key Plan

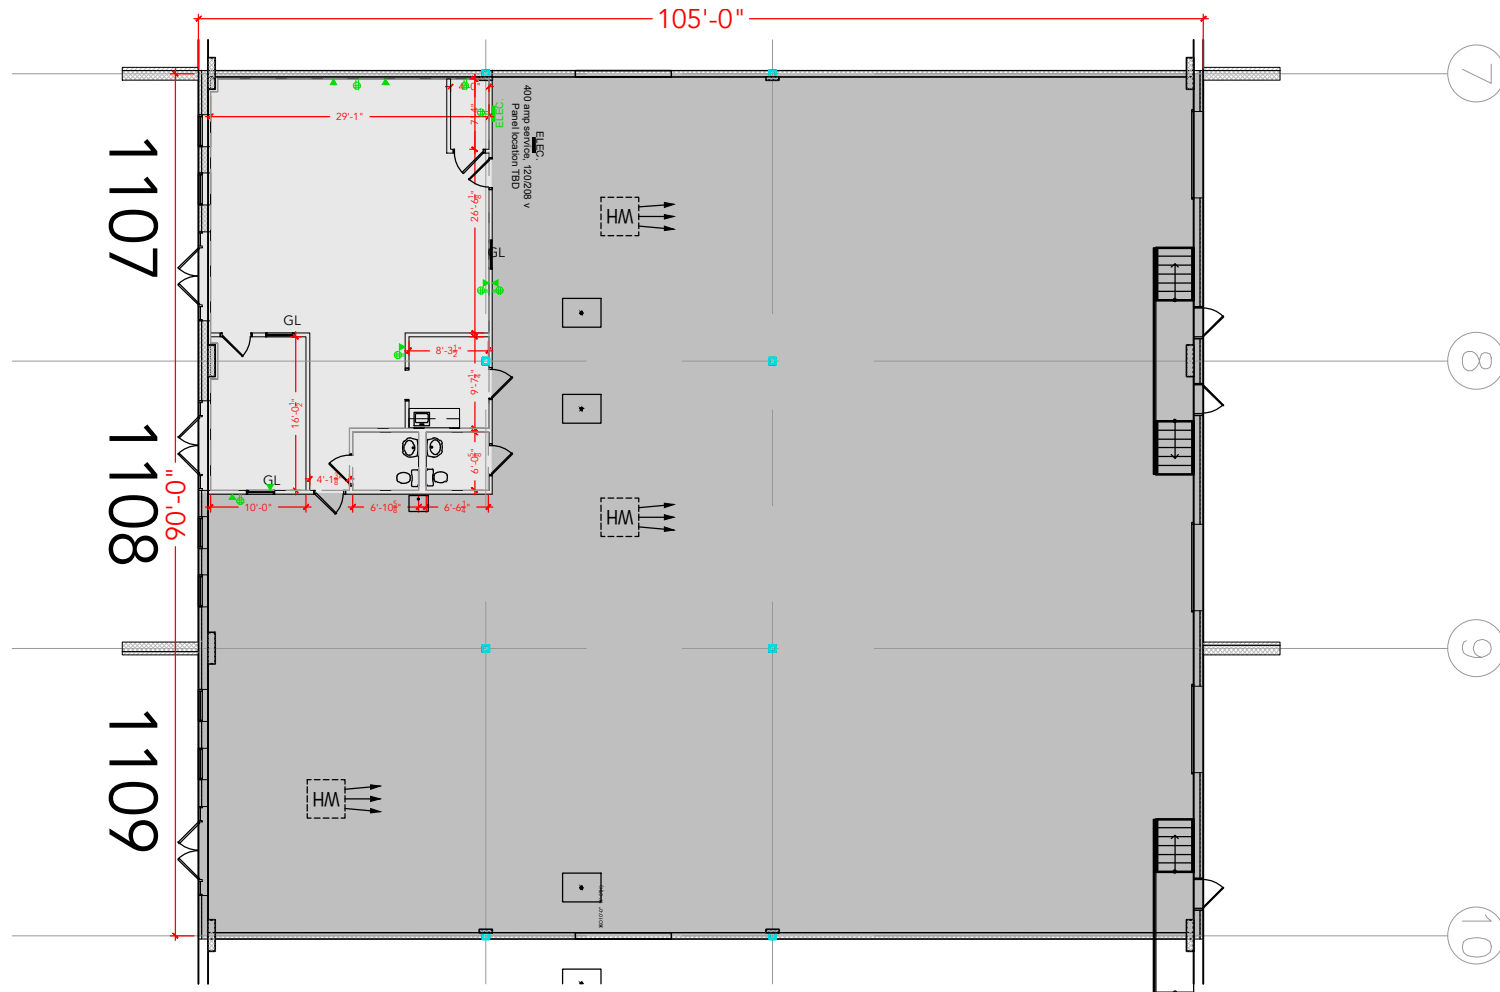

Floor Plan