


TOTAL SF AVAILABLE -6,239 SF


OFFICE - 576 SF

WAREHOUSE SF - 5,663 SF

[Click to access 3D model](#)

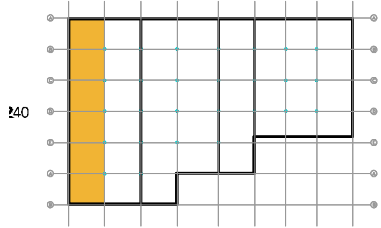

Key Plan

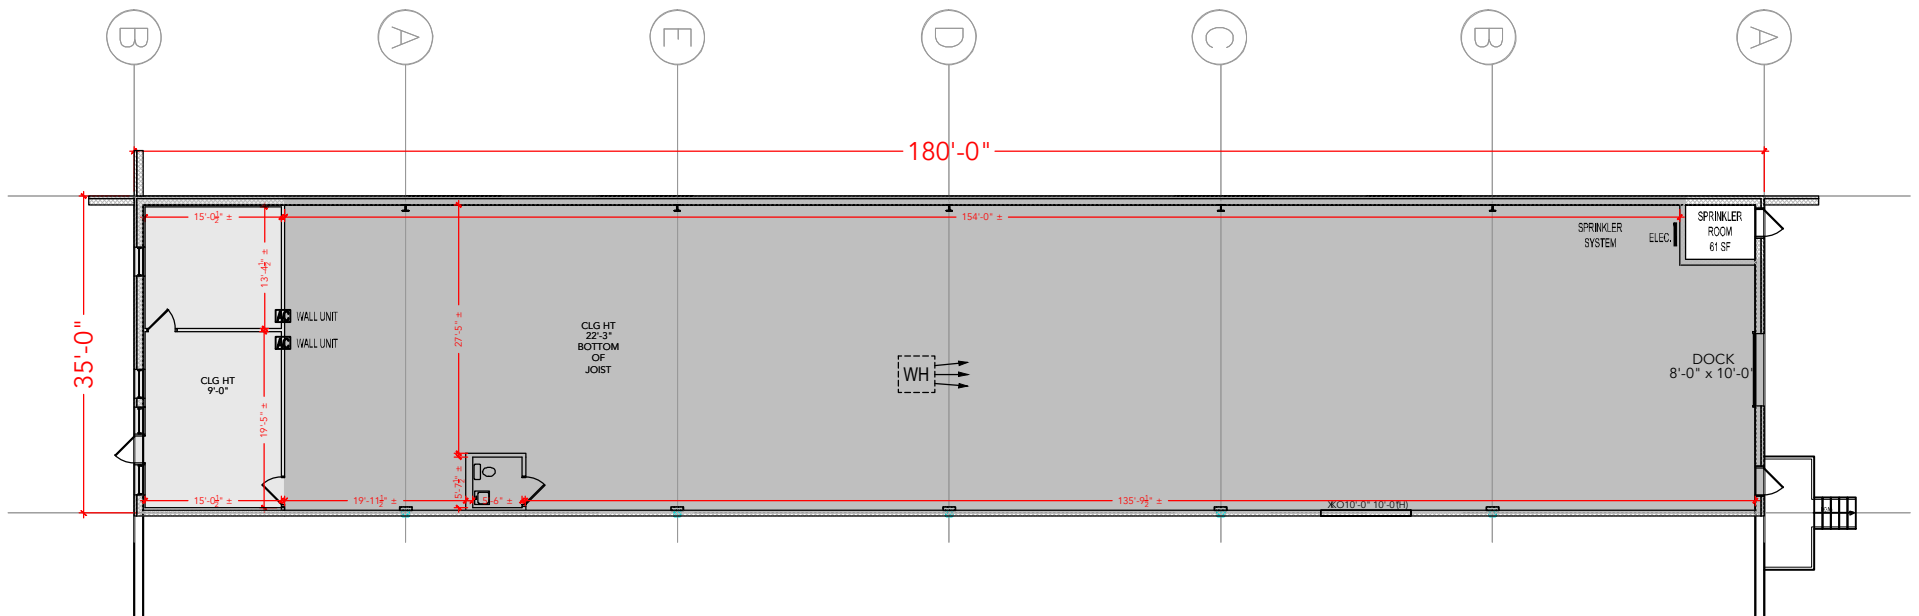

Floor Plan