



TOTAL SF AVAILABLE - 2,561 RSF

[Click to access 3D model](#)

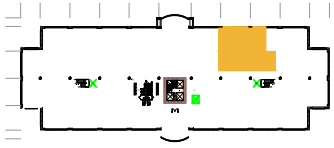

Key Plan

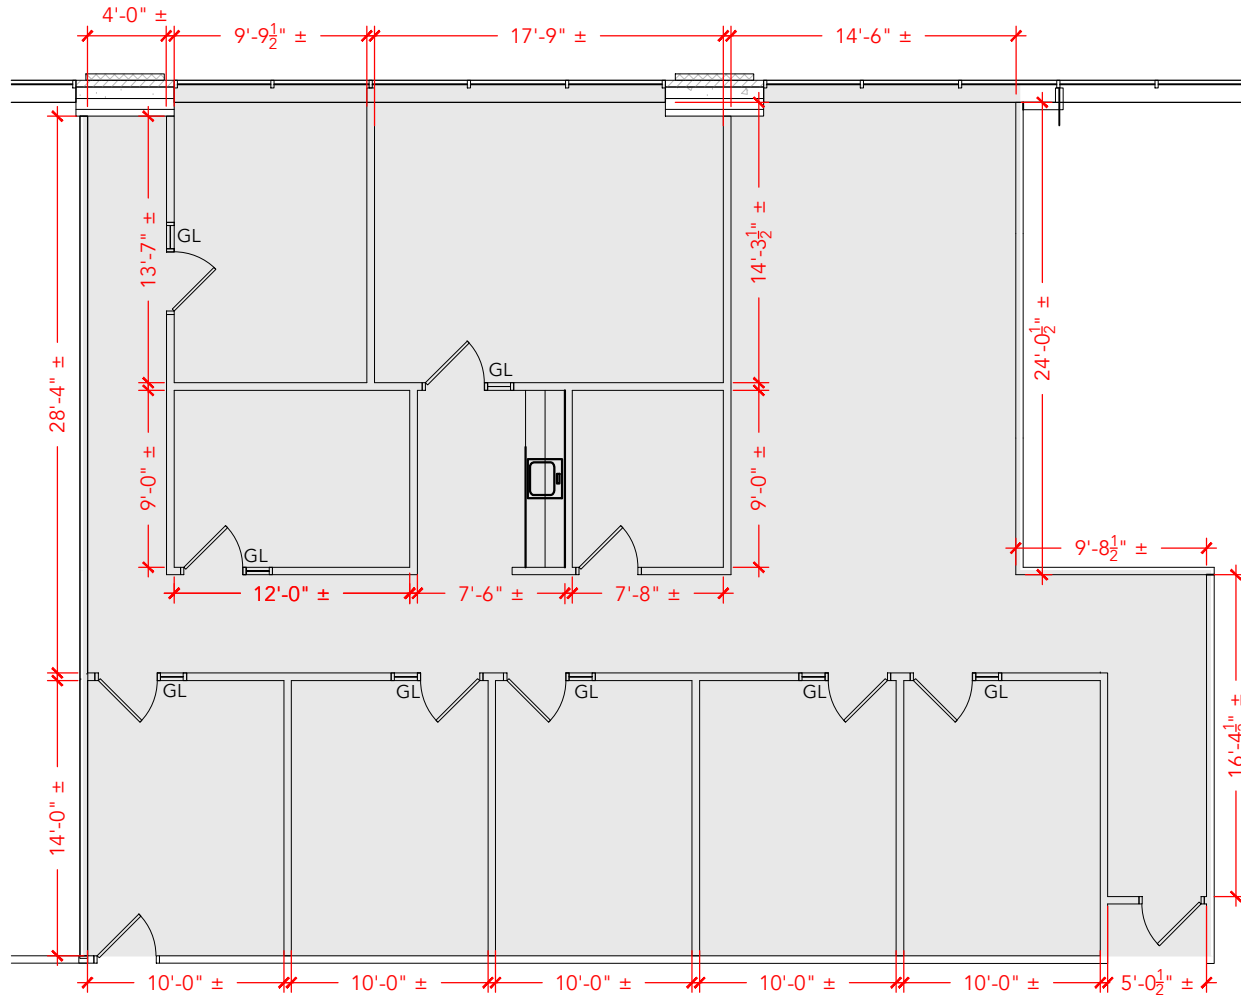

Floor Plan