


**TOTAL SF AVAILABLE -2,700 SF**


**OFFICE - 2,365 SF**

**WAREHOUSE - 335 SF**

[Click to access 3D model](#)

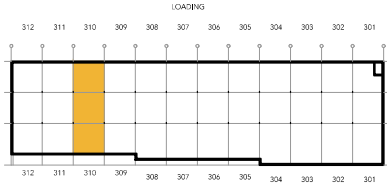

Key Plan

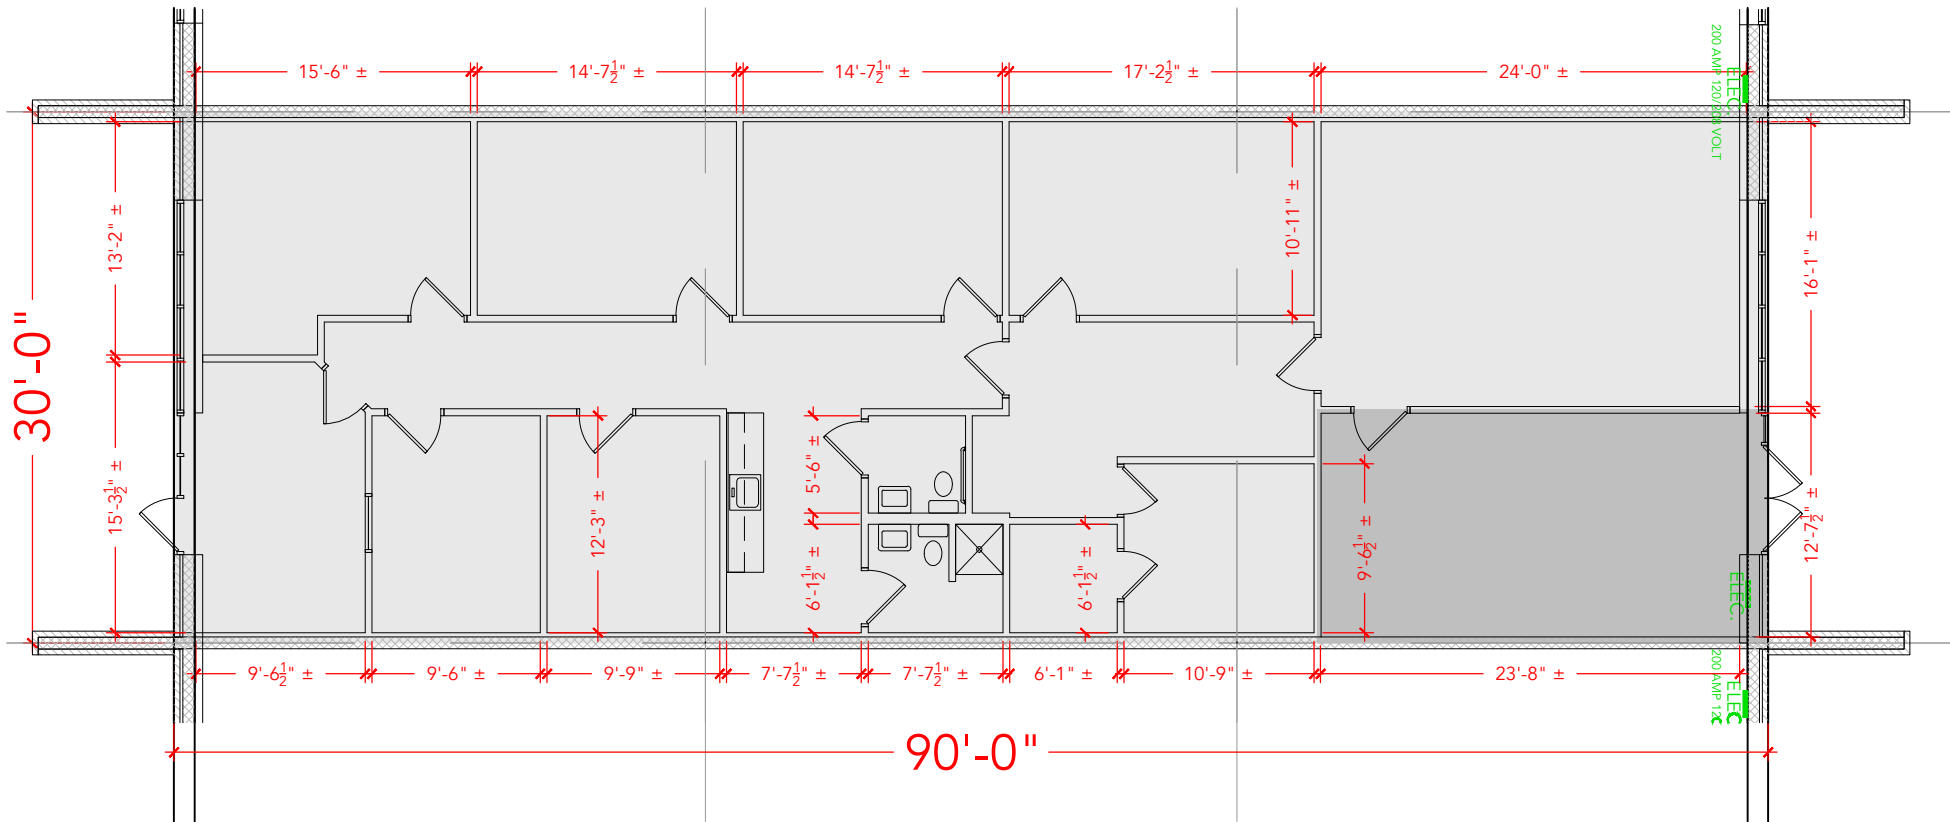

Floor Plan