



TOTAL SF AVAILABLE - 3,579 RSF (16%)

[Click to access 3D model](#)

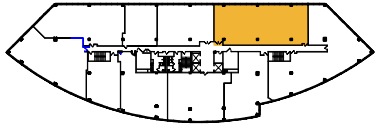

Key Plan

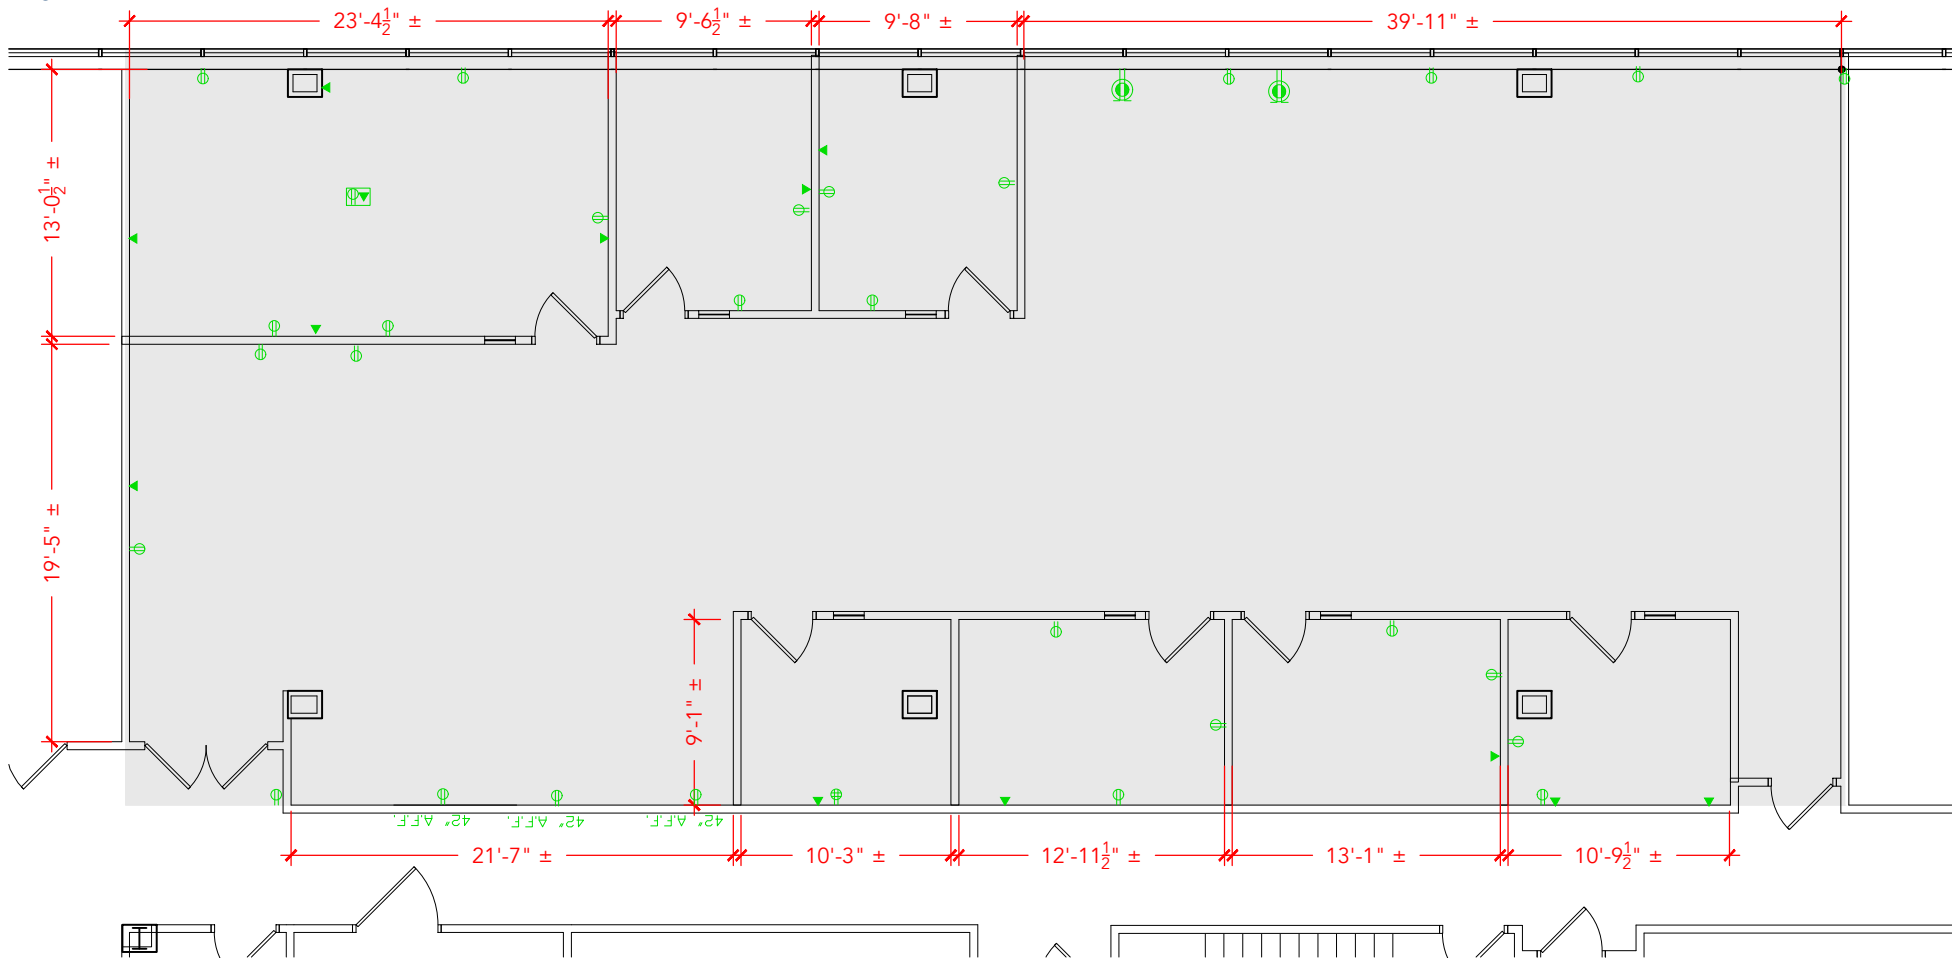

Floor Plan