



TOTAL SF AVAILABLE - 1,096 RSF(16%)

[Click to access 3D model](#)

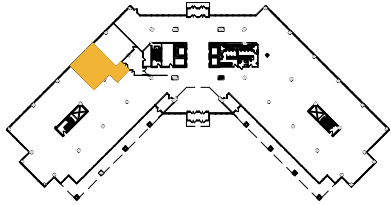

Key Plan

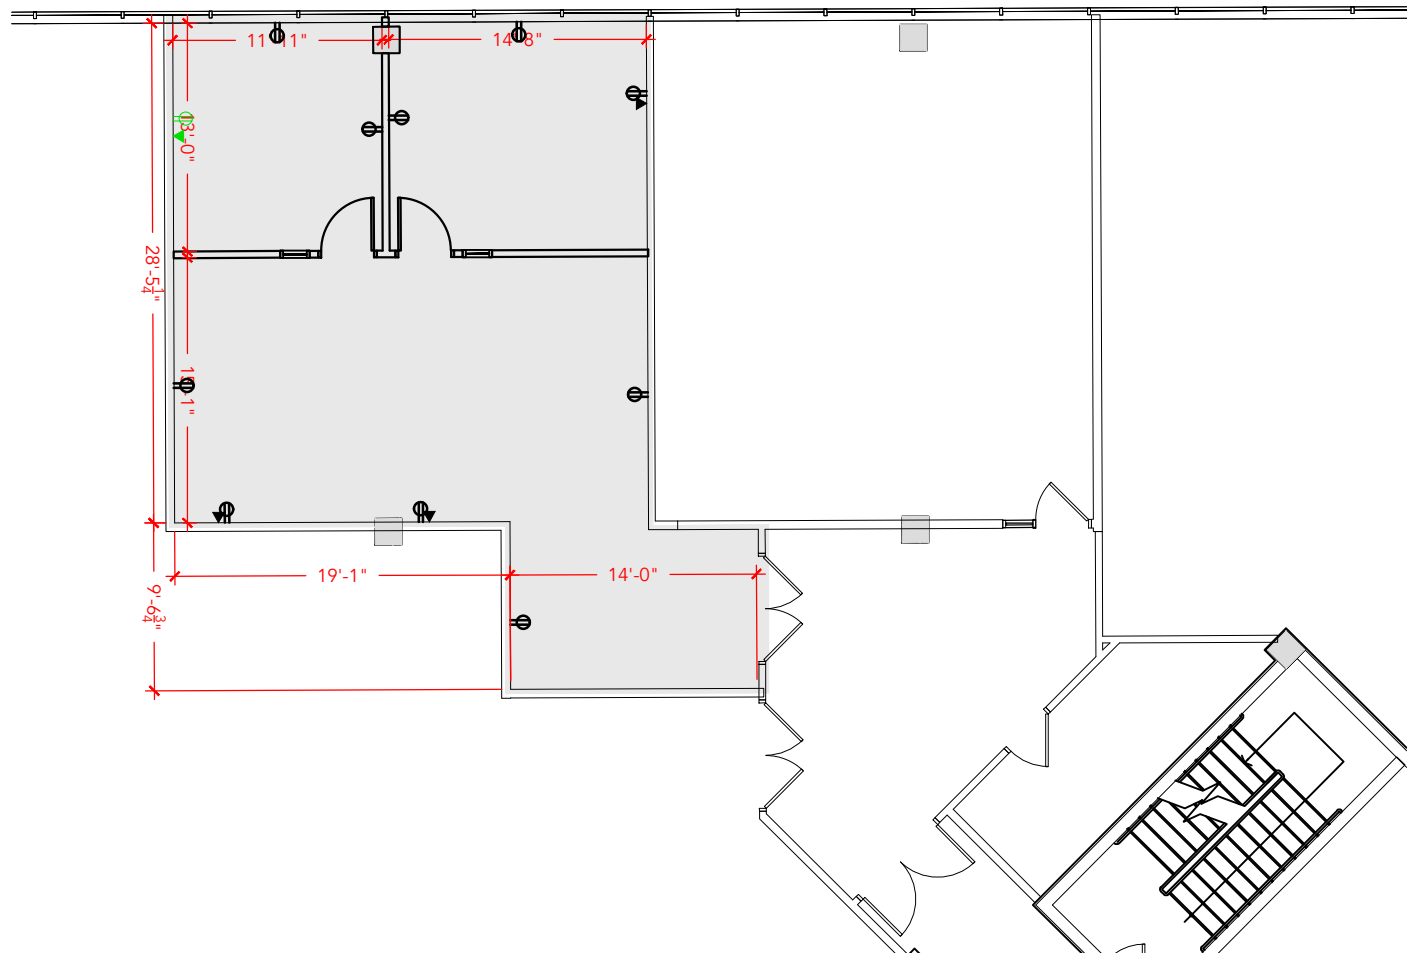

Floor Plan