


TOTAL SF AVAILABLE - 1,088 RSF(16%)

[Click to access 3D model](#)

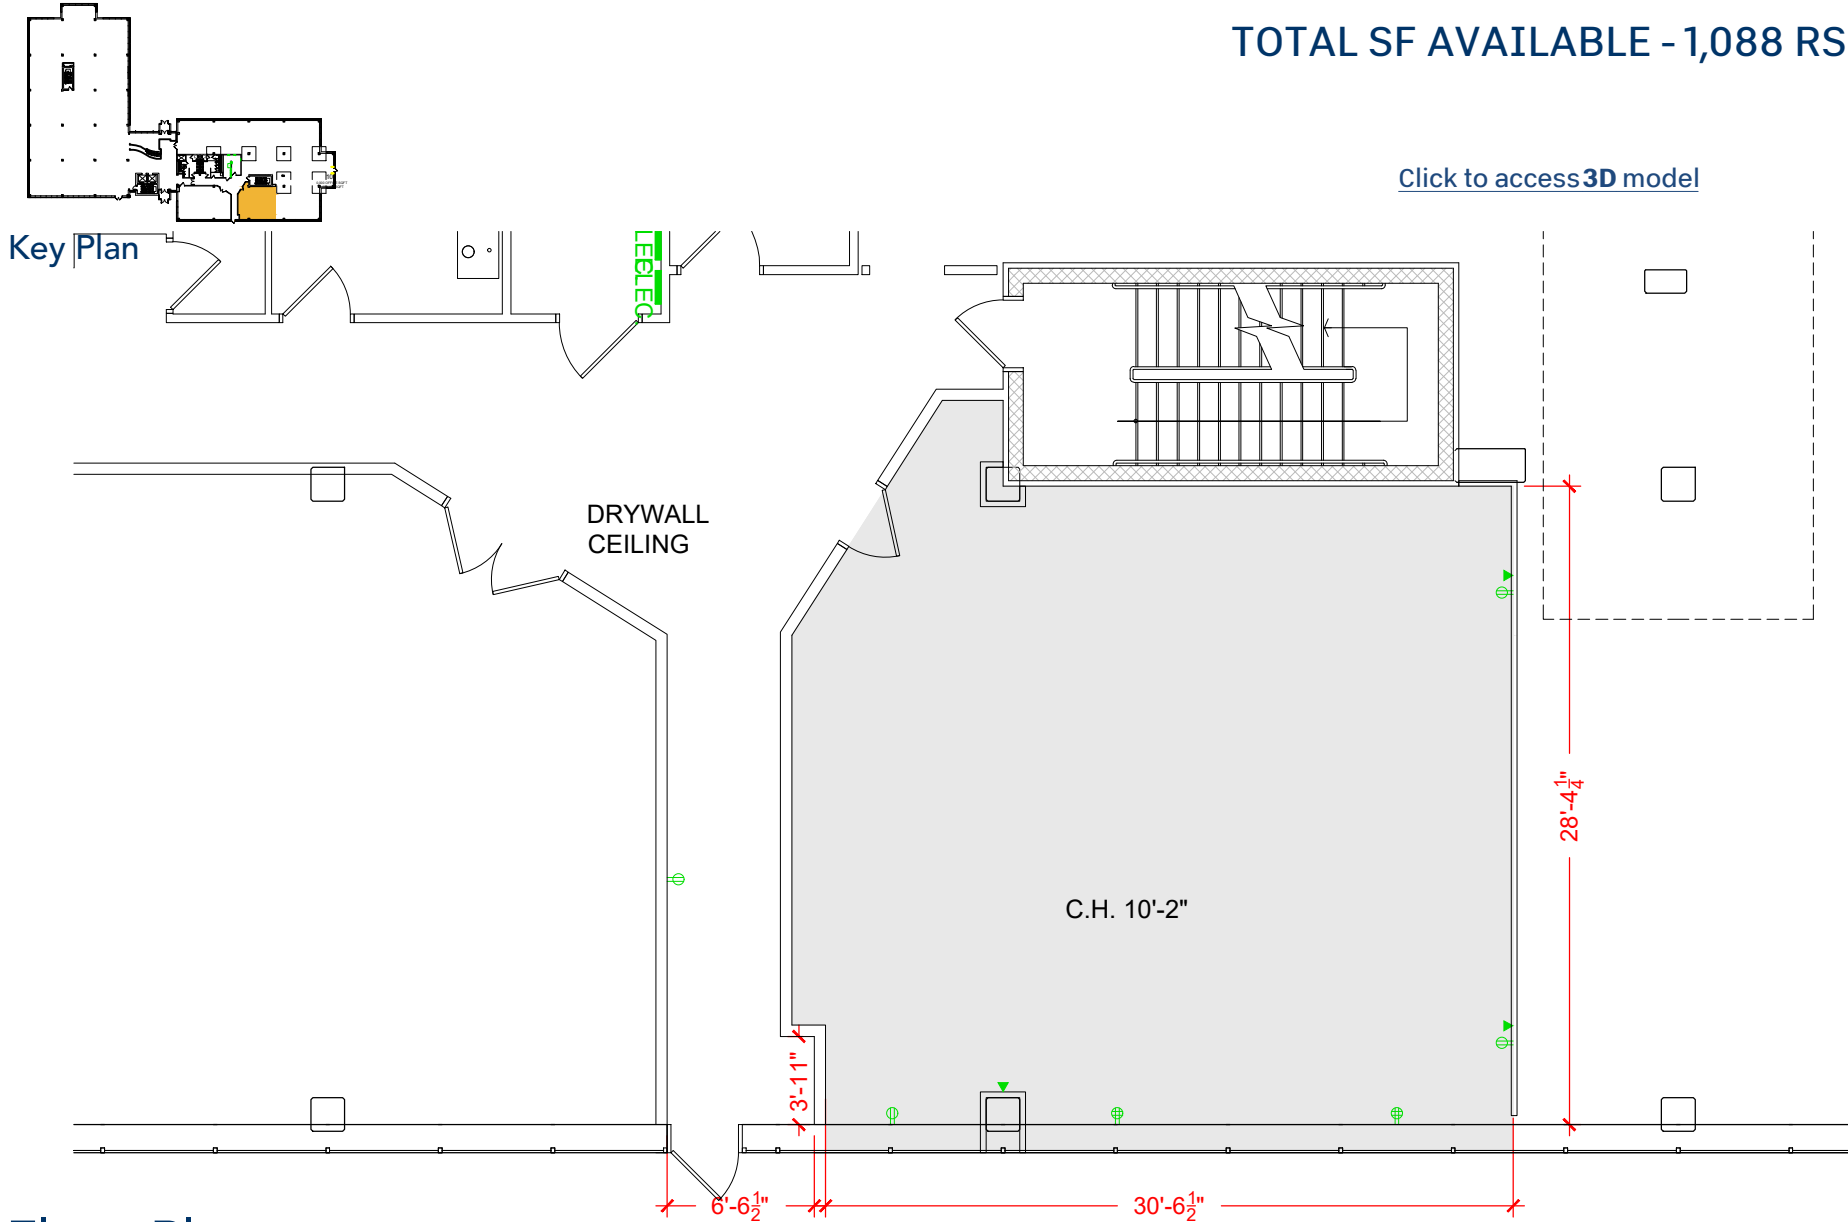

Floor Plan