


TOTAL SF AVAILABLE - 1,088 RSF(16%)

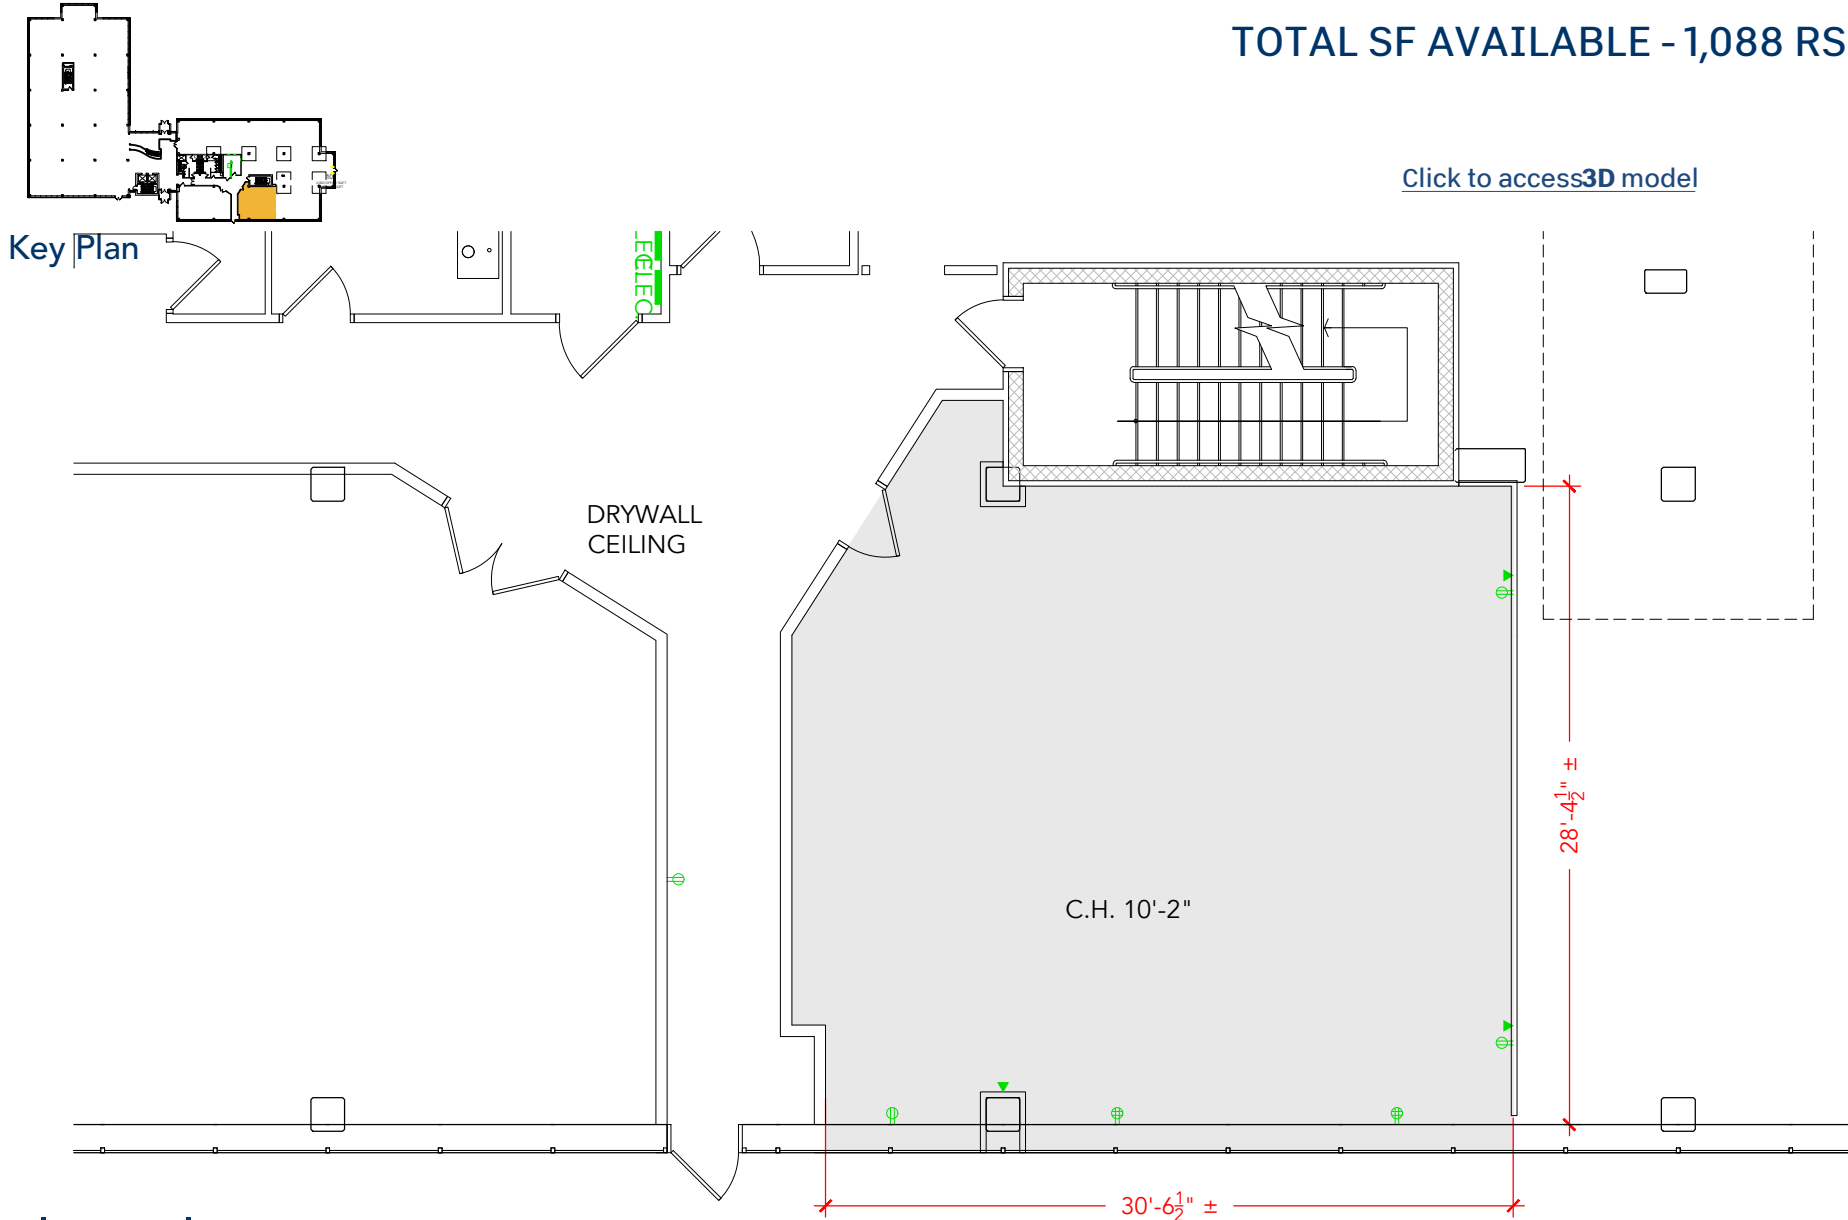

## Floor Plan