



TOTAL SF AVAILABLE -5,348 RSF(16%)

[Click to access 3D model](#)

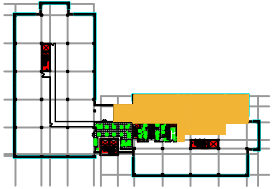

Key Plan

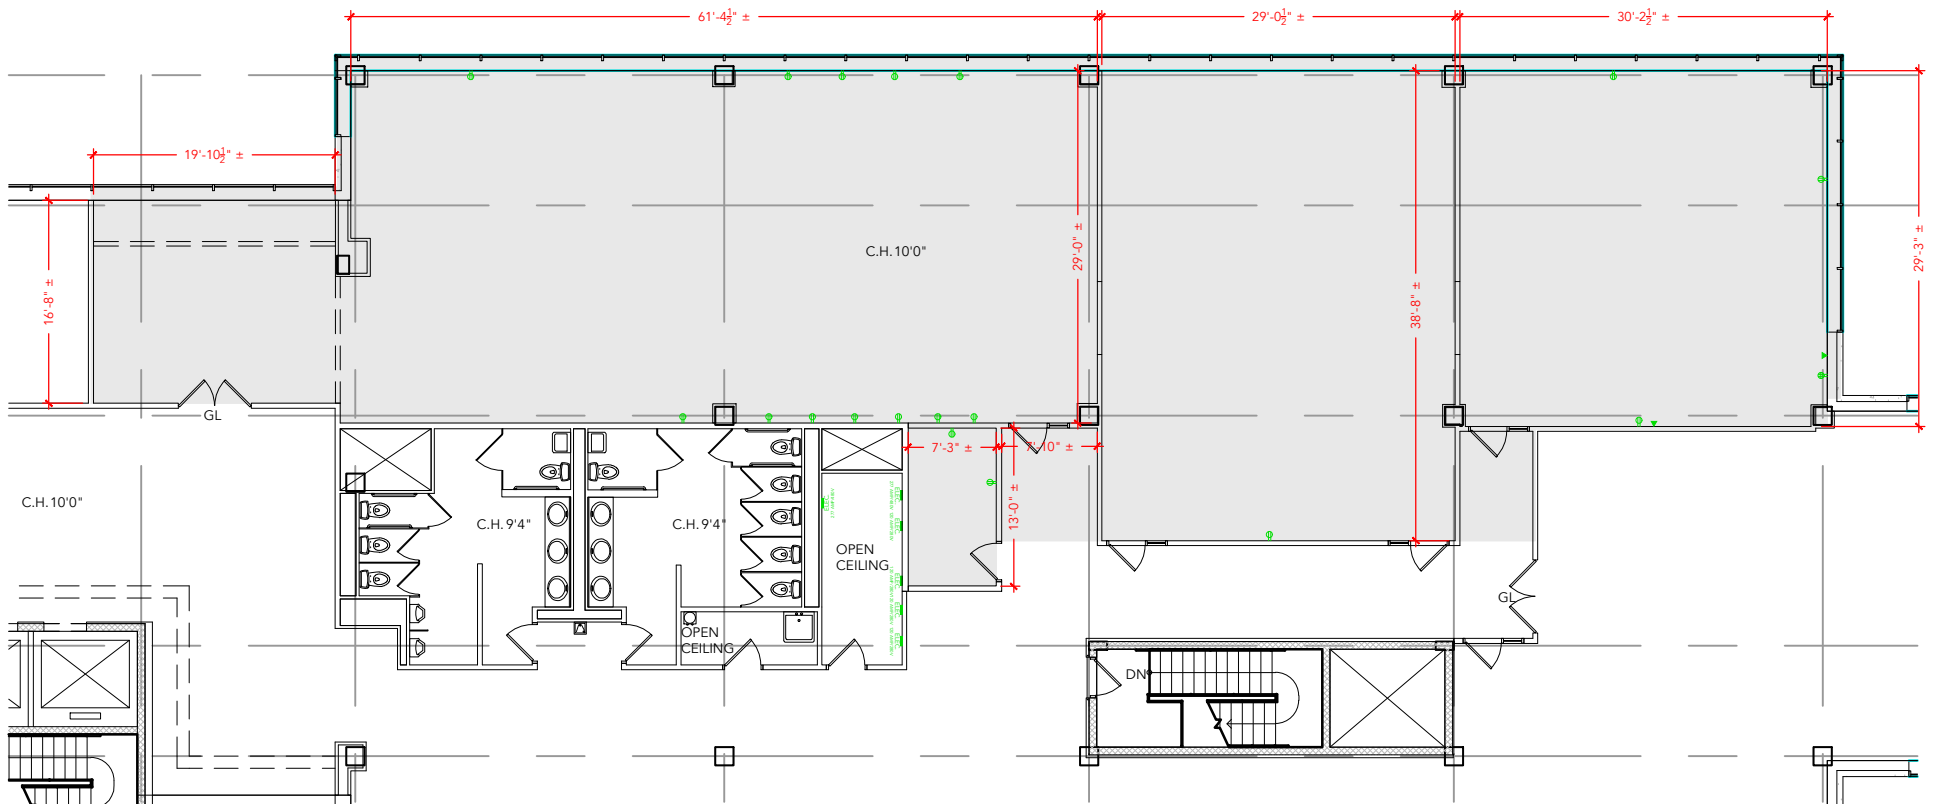

Floor Plan