

**TOTAL SF AVAILABLE -3,636 RSF**


OFFICE - 791 RSF

WAREHOUSE - 2,845 RSF

\* INCLUDES % OF METER ROOM

[Click to access 3D model](#)

## Key Plan

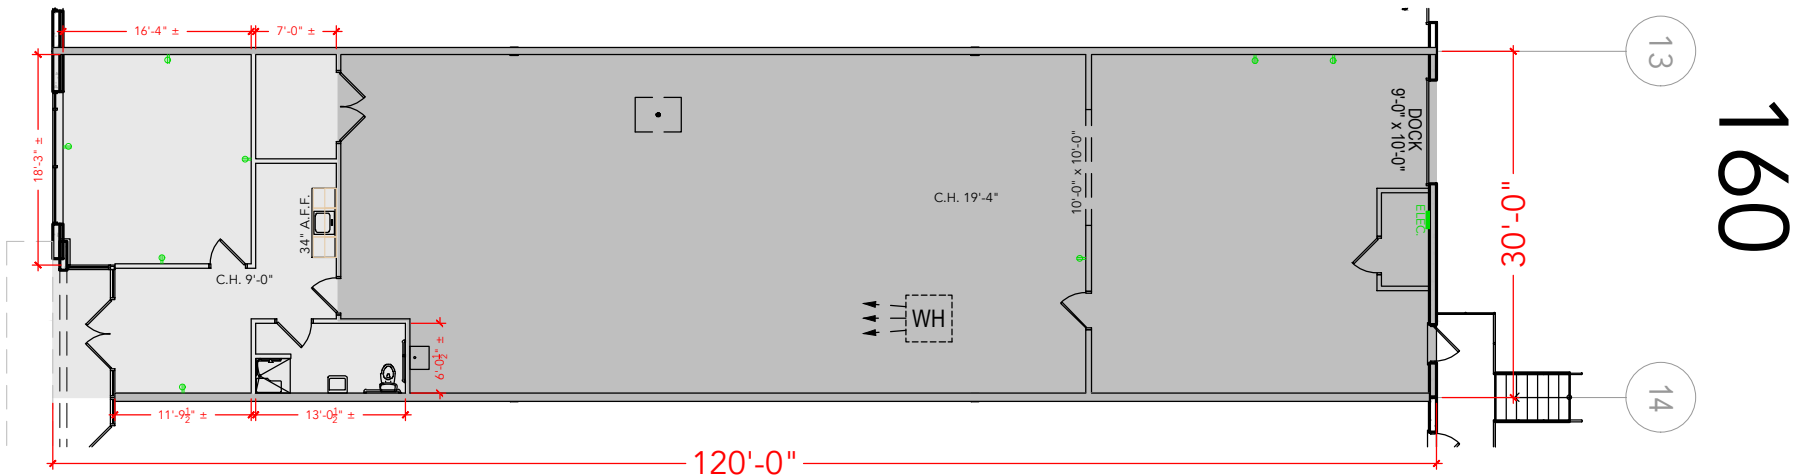

## Floor Plan