

TOTAL SF AVAILABLE - 3,528 RSF


OFFICE - 0,000 RSF

WAREHOUSE - 3,528 RSF



100

Key Plan

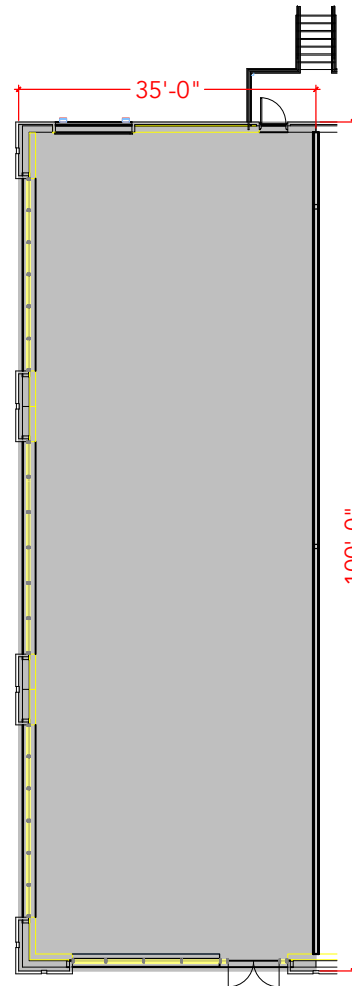

Floor Plan