



**TOTAL SF AVAILABLE - 4,986 RSF**


**OFFICE - 0,000 SF**

**WAREHOUSE - 4,986 RSF**

\* INCLUDES % OF METER ROOM

[Click to access CADD file](#)

Key Plan

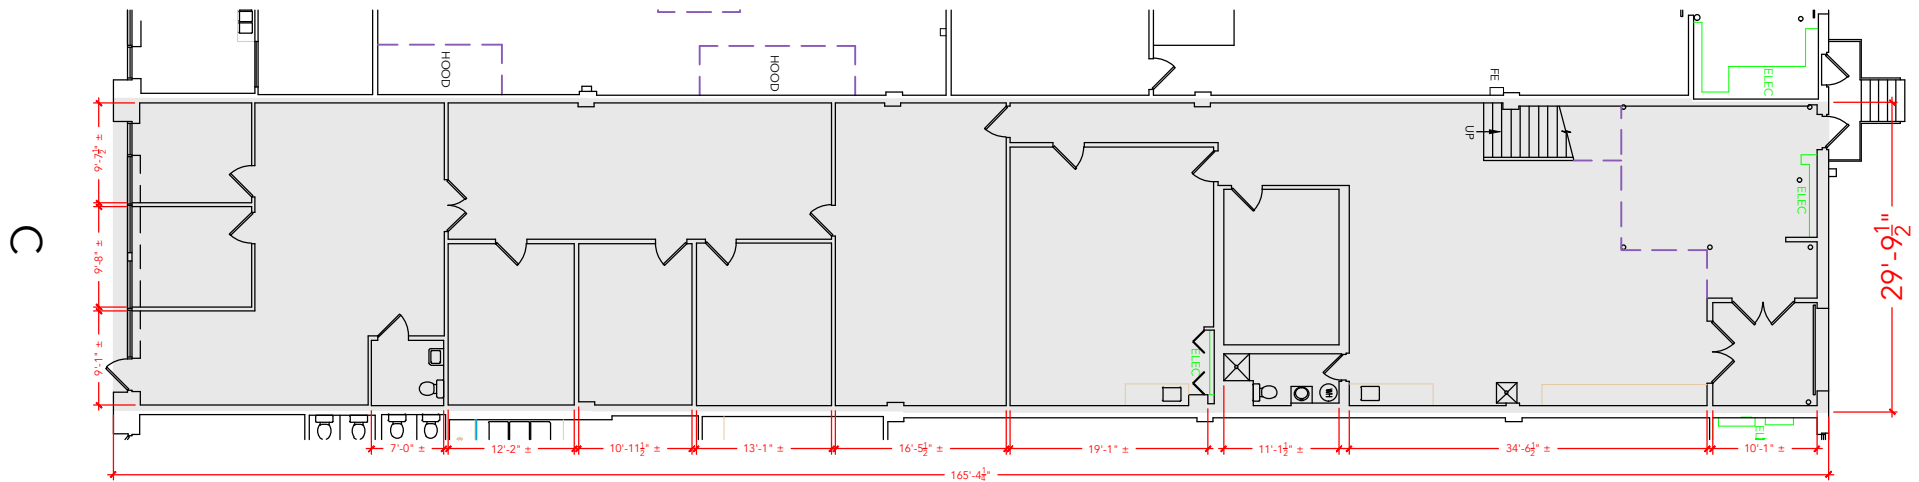

Floor Plan