


**TOTAL SF AVAILABLE -21,600 SF**

OFFICE - 2,675 SF


WAREHOUSE SF - 18,925 SF

[Click to access 3D model](#)

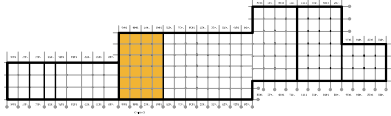

Key Plan

LOADING

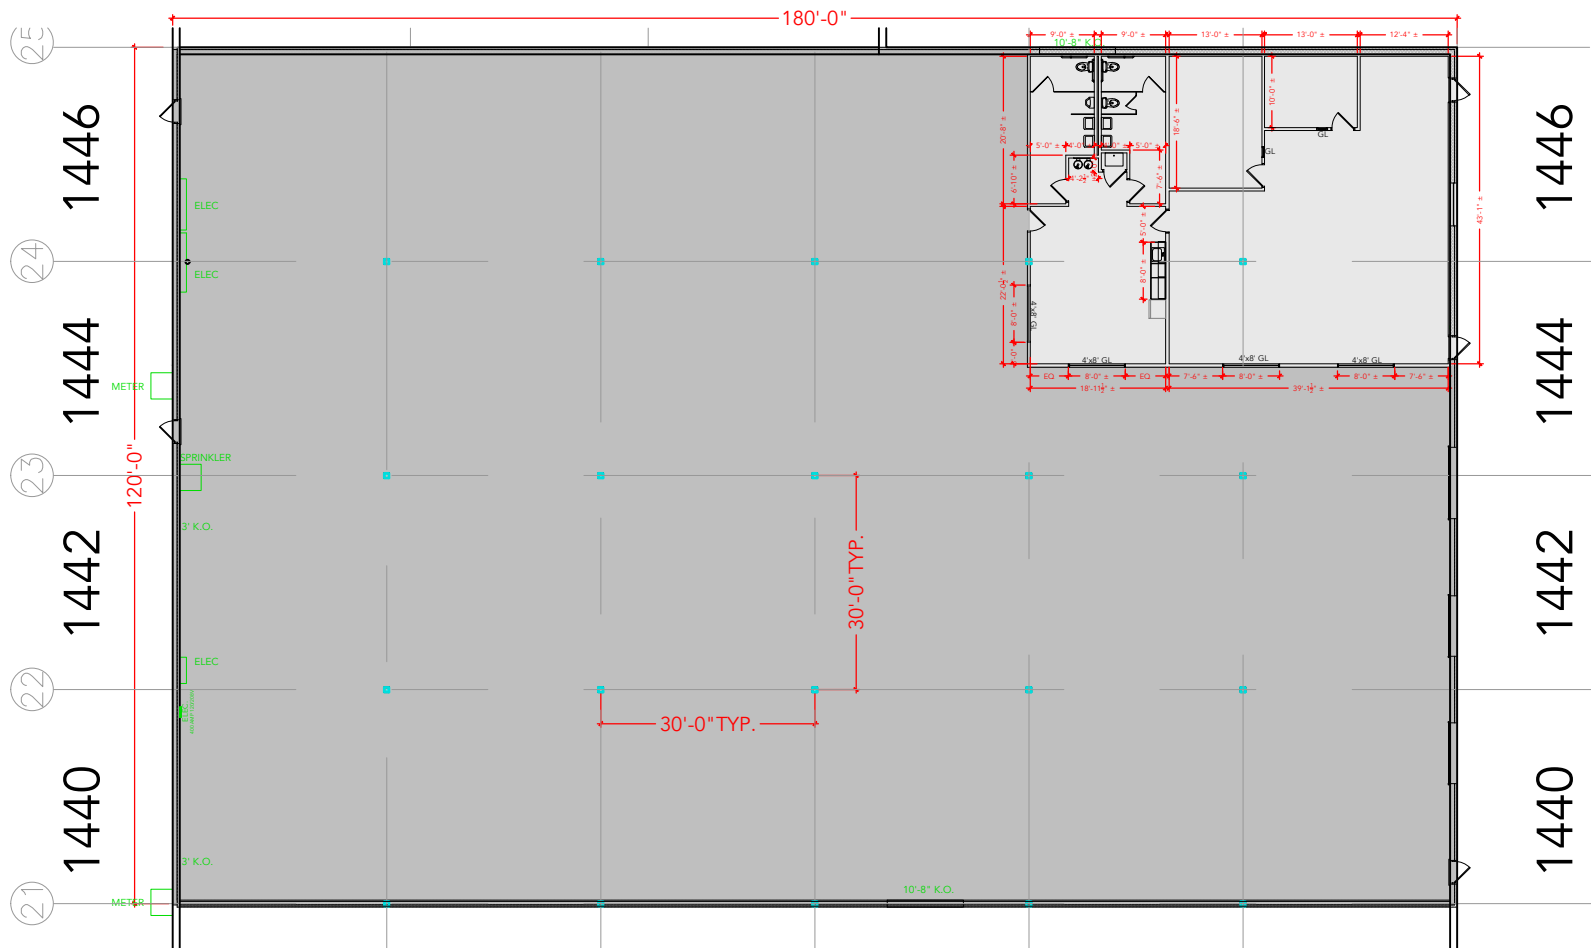

Floor Plan