


**TOTAL SF AVAILABLE - 3,000 SF**


**OFFICE - 2,583 SF**

**WAREHOUSE SF - 417 SF**

[Click to access 3D model](#)

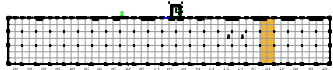

## Key Plan

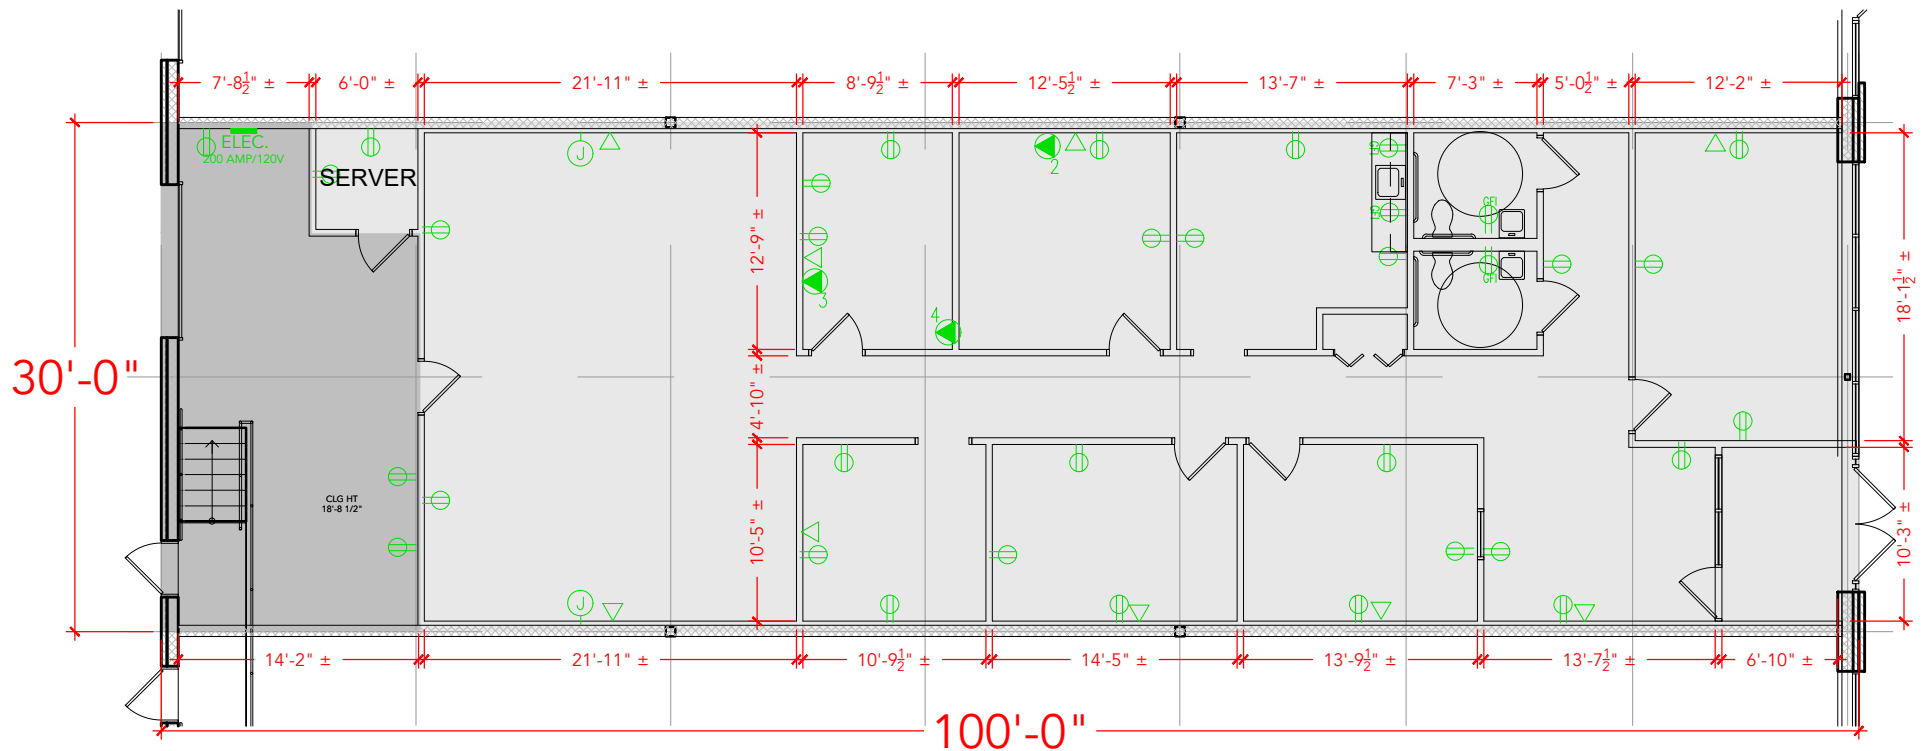

## Floor Plan