


TOTAL SF AVAILABLE - 5,400 SF


OFFICE - 3,068 SF

WAREHOUSE SF - 2,332 SF

[Click to access 3D model](#)

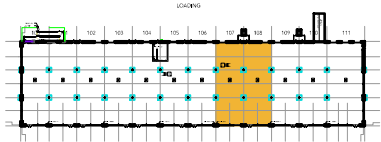

### Key Plan

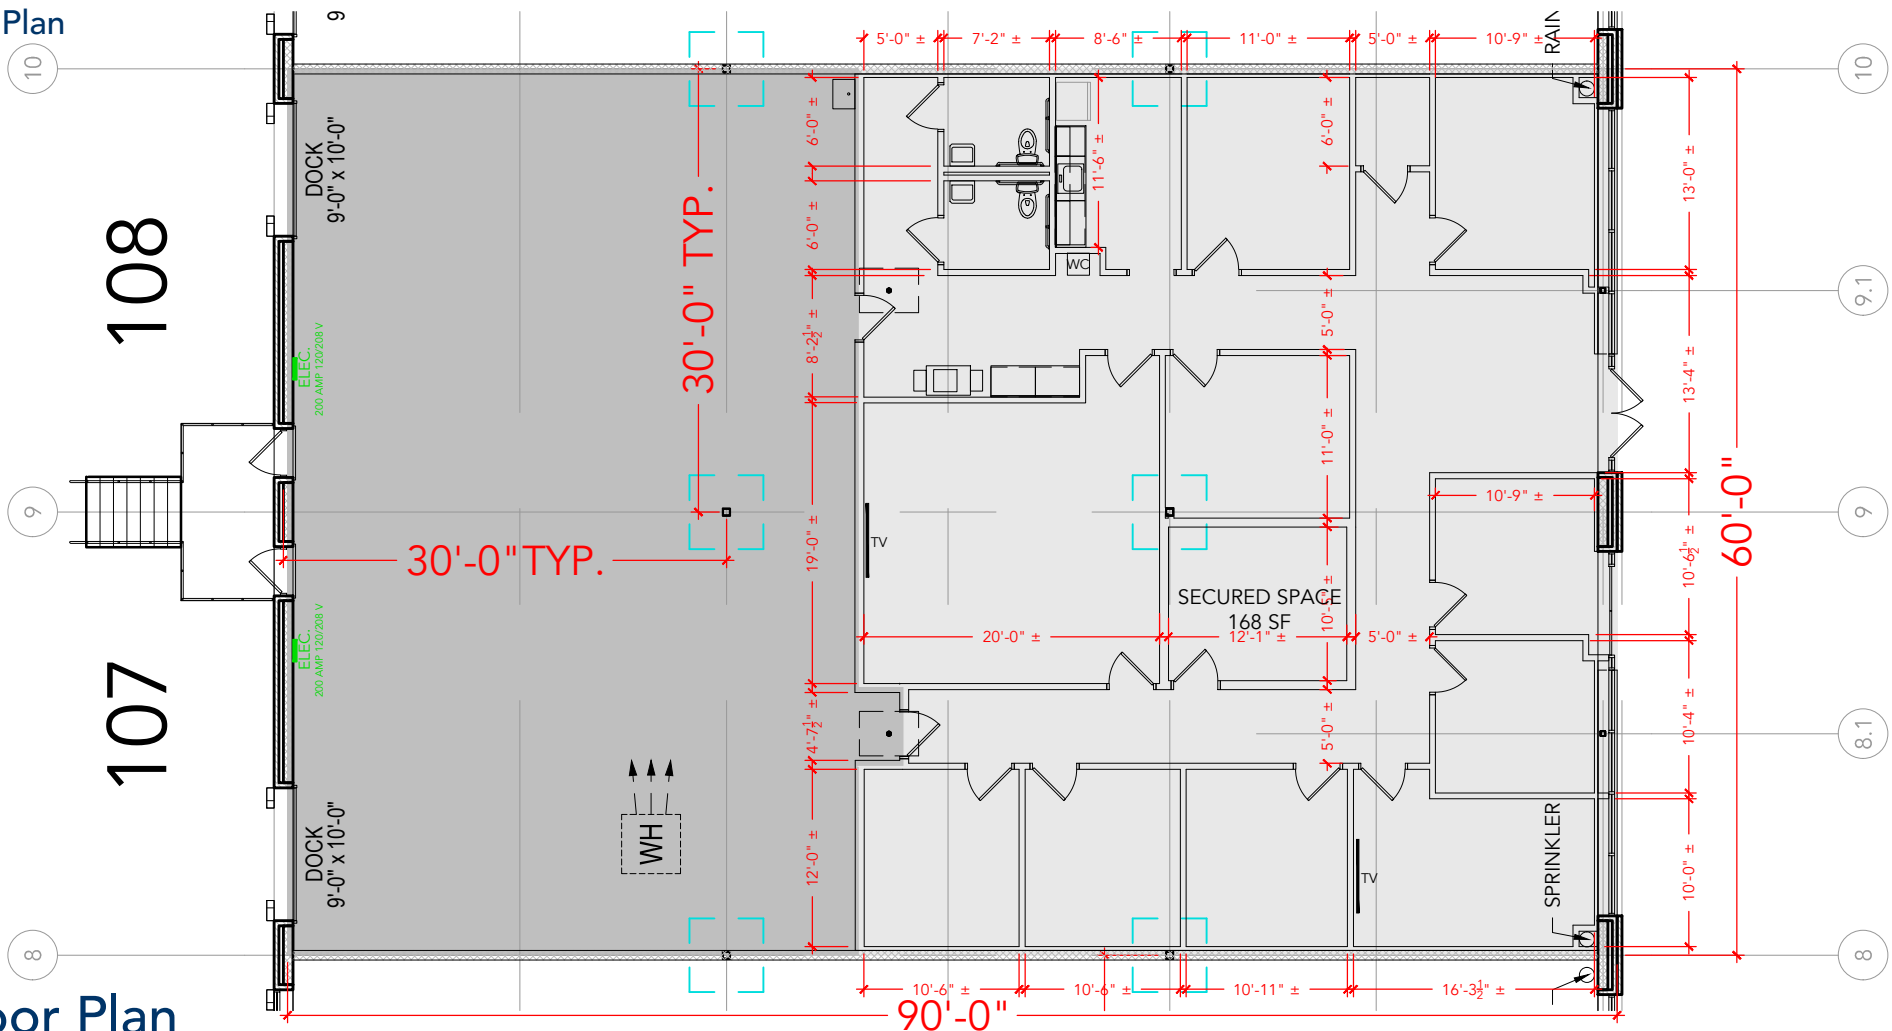

### Floor Plan