



TOTAL SF AVAILABLE -1,800 SF

OFFICE - 1,800 SF
WAREHOUSE - 0,000 SF

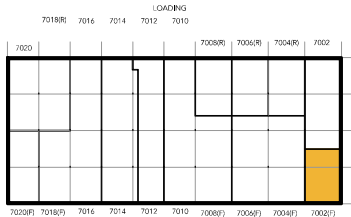

Key Plan

7002(F)
35'-0"

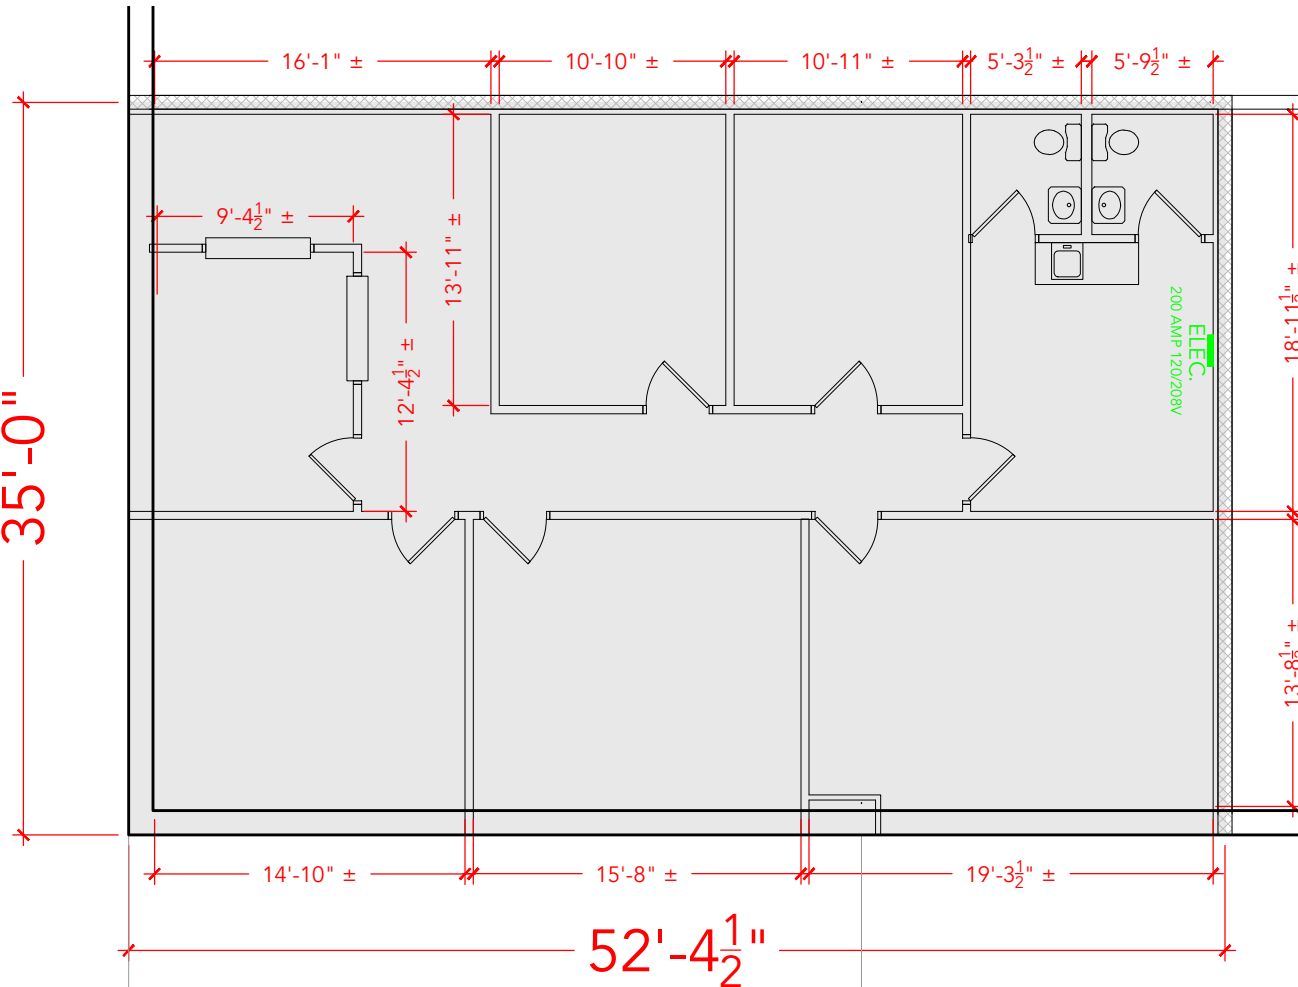

Floor Plan