


TOTAL SF AVAILABLE -2,972 SF


OFFICE - 181 SF

WAREHOUSE SF - 2,791 SF

[Click to access 3D model](#)

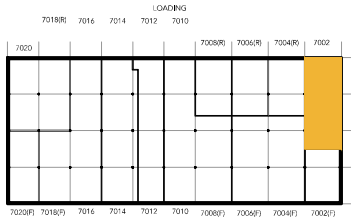

Key Plan

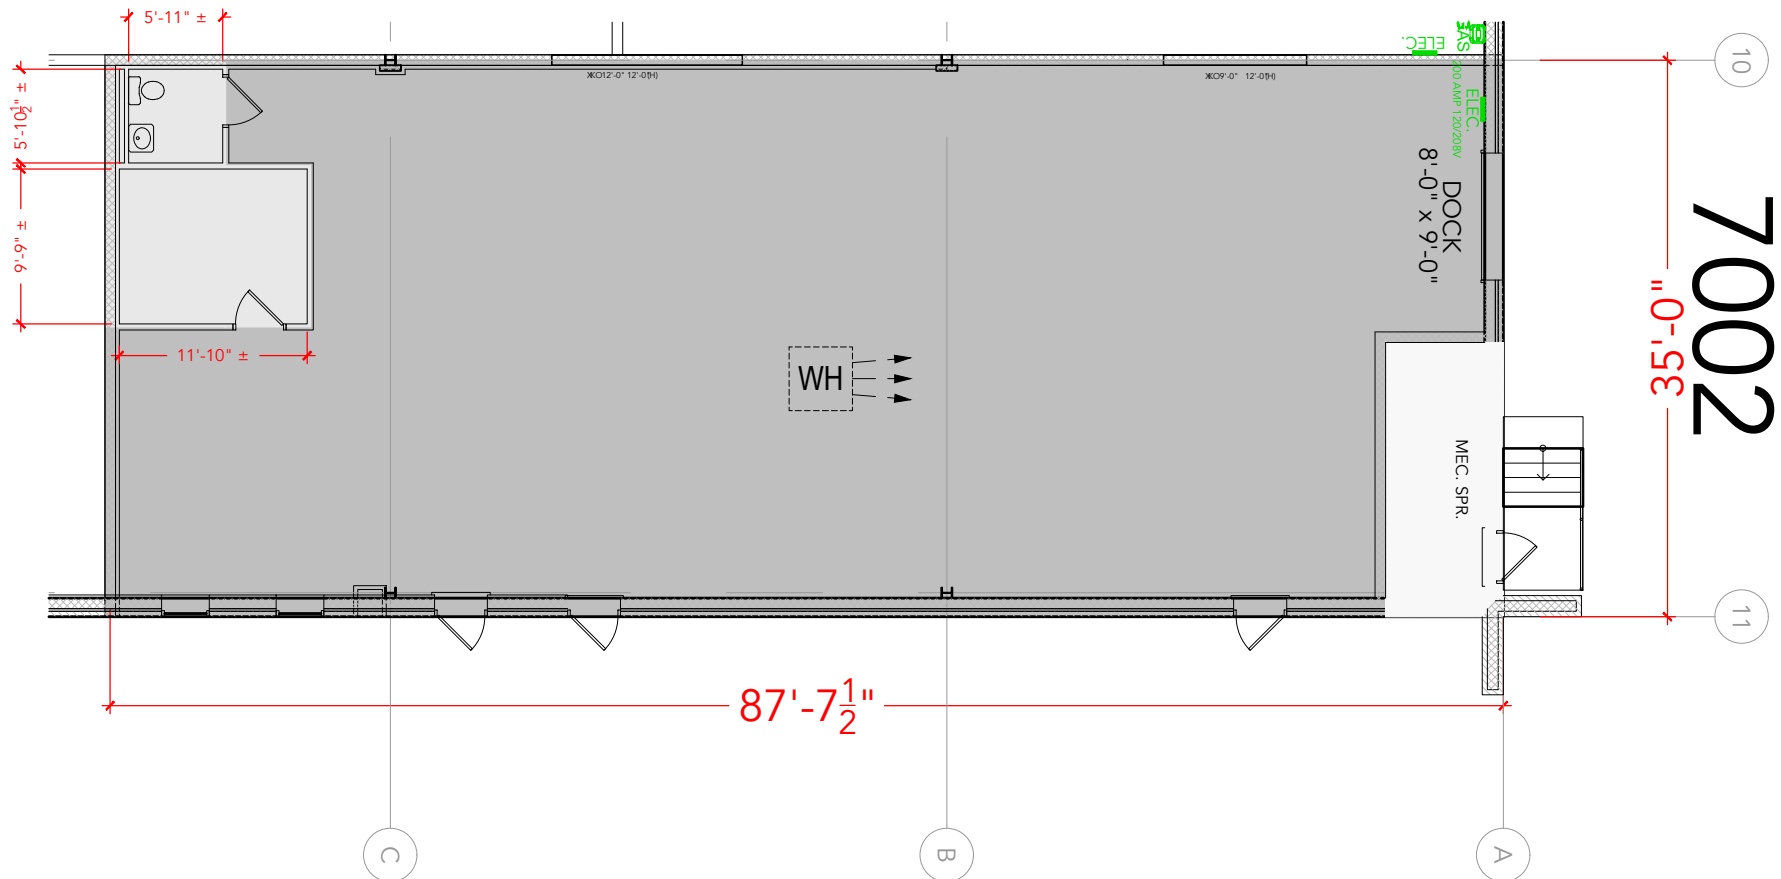

Floor Plan