



TOTAL SF AVAILABLE - 3,550 SF

OFFICE - 601 SF
 WAREHOUSE SF - 2,949 SF
 * 615 SQFT MEZZ. NOT INCLUDED IN TOTAL SQFT
[Click to access 3D model](#)

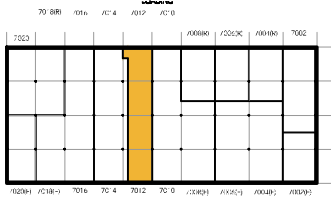

Key Plan

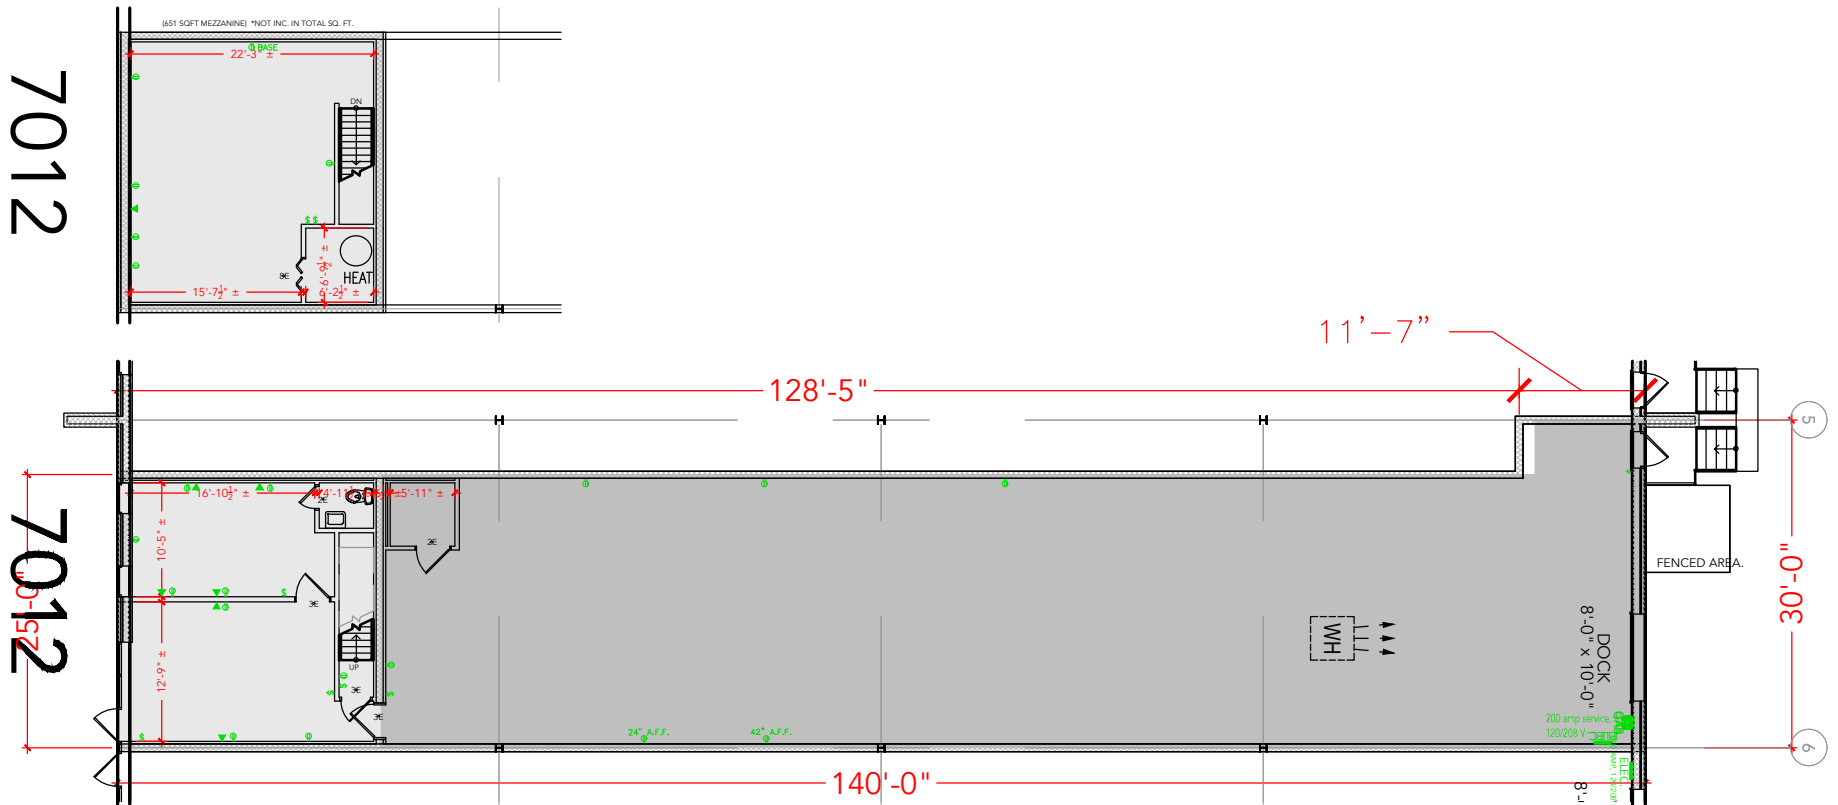

Floor Plan