

Key Plan


**TOTAL SF AVAILABLE - 4,200 SF**

OFFICE - 272 SF

WAREHOUSE - 3,928 SF

[Click to access 3D model](#)

7018(R)

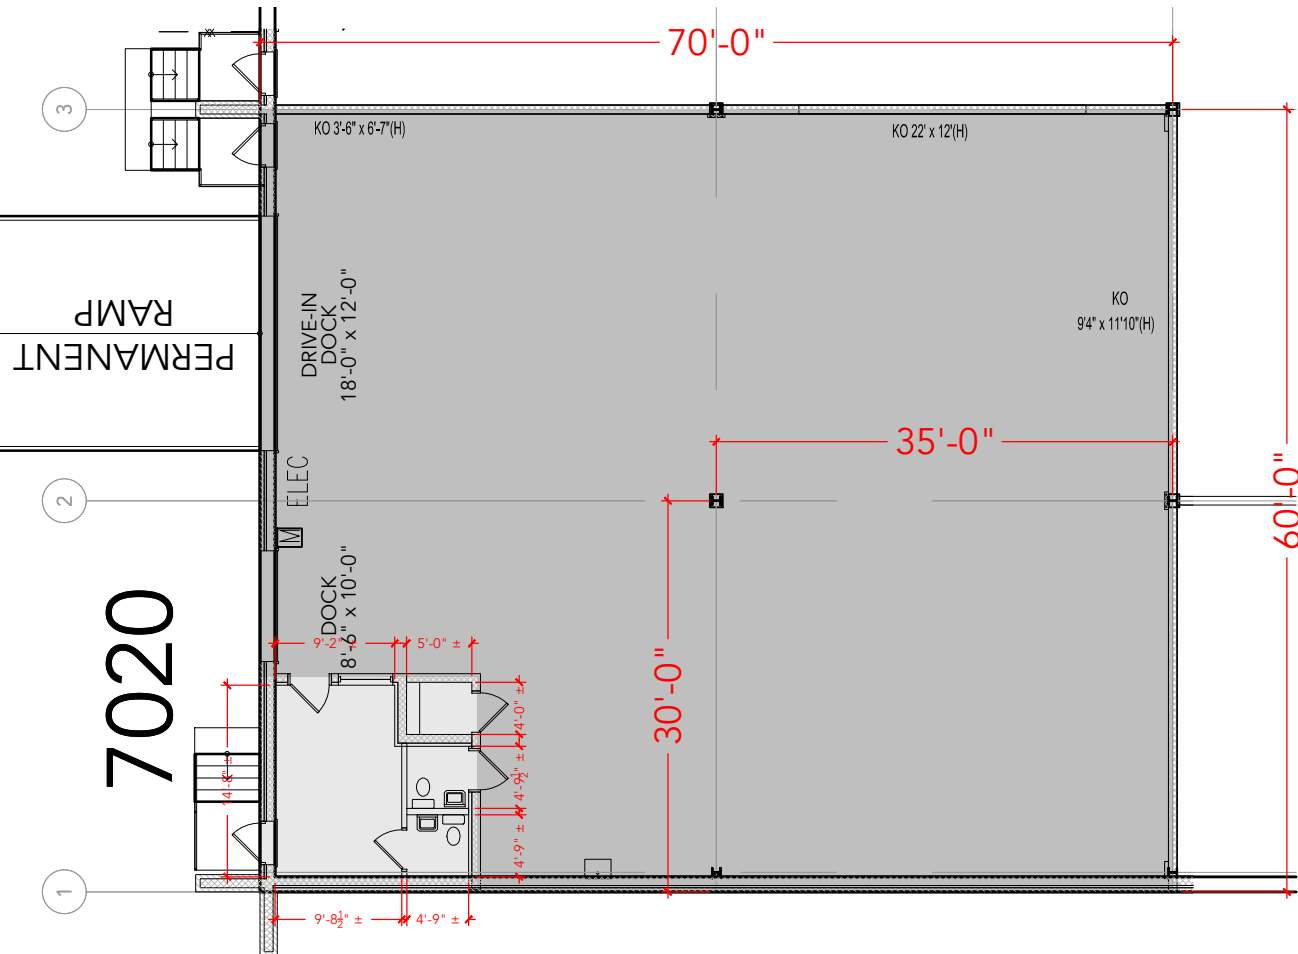

## Floor Plan