


TOTAL SF AVAILABLE - 3,000 SF


OFFICE - 0,000 SF

WAREHOUSE - 3,000 SF

[Click to access 3D model](#)

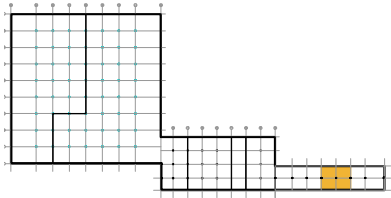

Key Plan

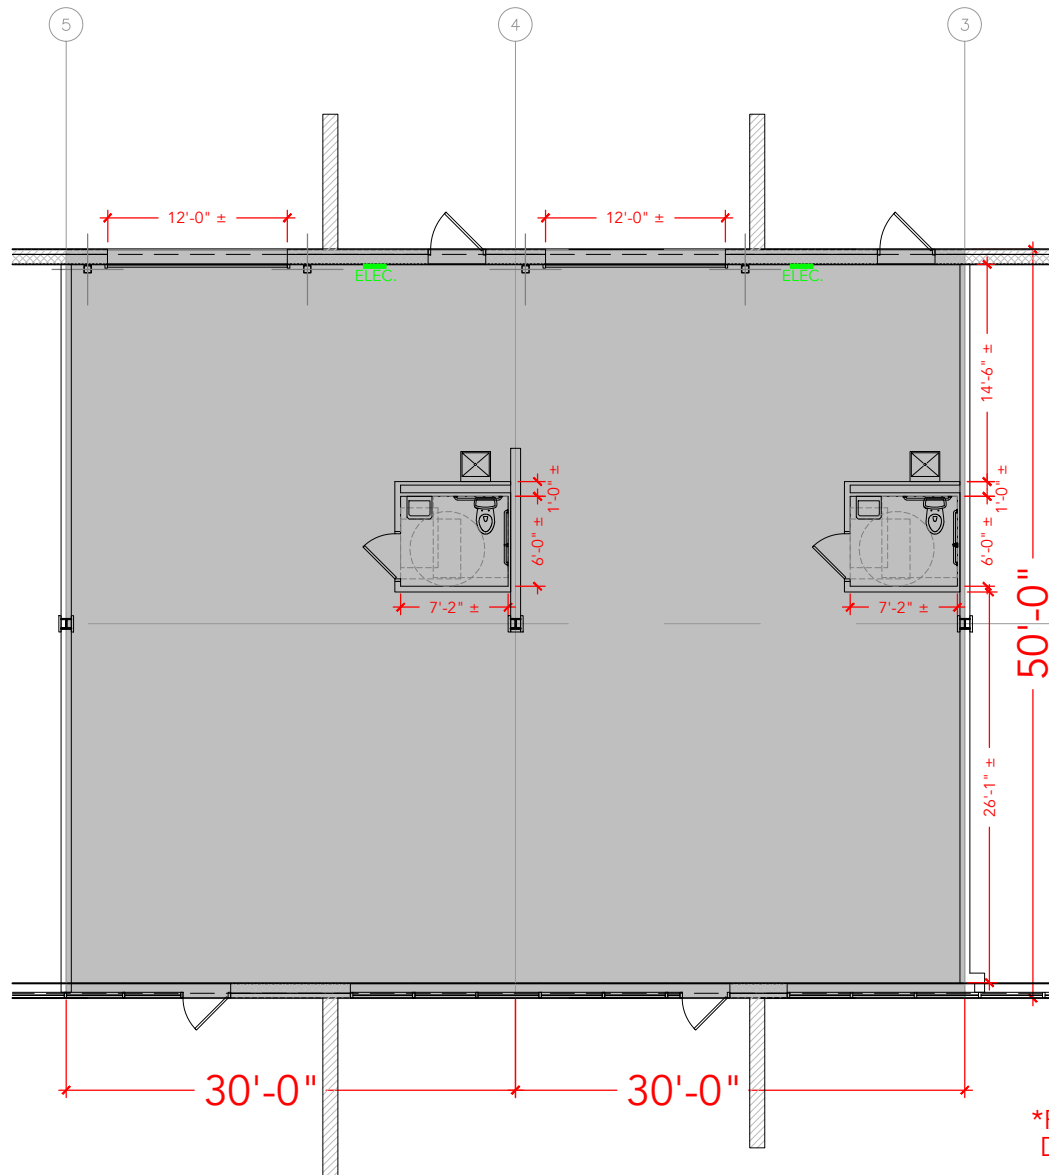

Floor Plan

PLAN NOT TO SCALE - THIS IS NOT A CONSTRUCTION DOCUMENT

***FIELD VERIFY EXISTENCE OF POSSIBLE DEMISING WALL AT COLUMN LINE**

DRAWING #: FP4-12117-C-D ASBUILT DATE: 02.04.21