


TOTAL SF AVAILABLE -6,000 SF


OFFICE - 0,000 SF

WAREHOUSE - 6,000 SF

[Click to access 3D model](#)

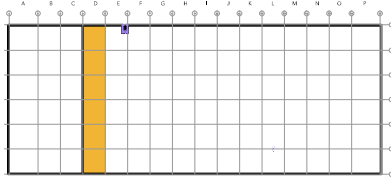

Key Plan

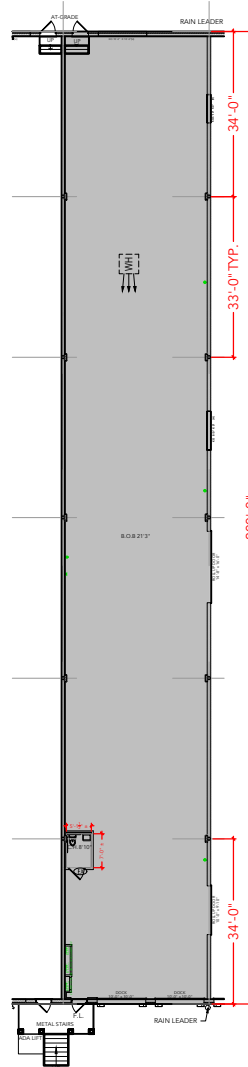

Floor Plan

PLAN NOT TO SCALE - THIS IS NOT A CONSTRUCTION DOCUMENT

DRAWING #: GJ1-D ASBUILT DATE: 08.29.2023