


[Click to access CADD file](#)

Key Plan

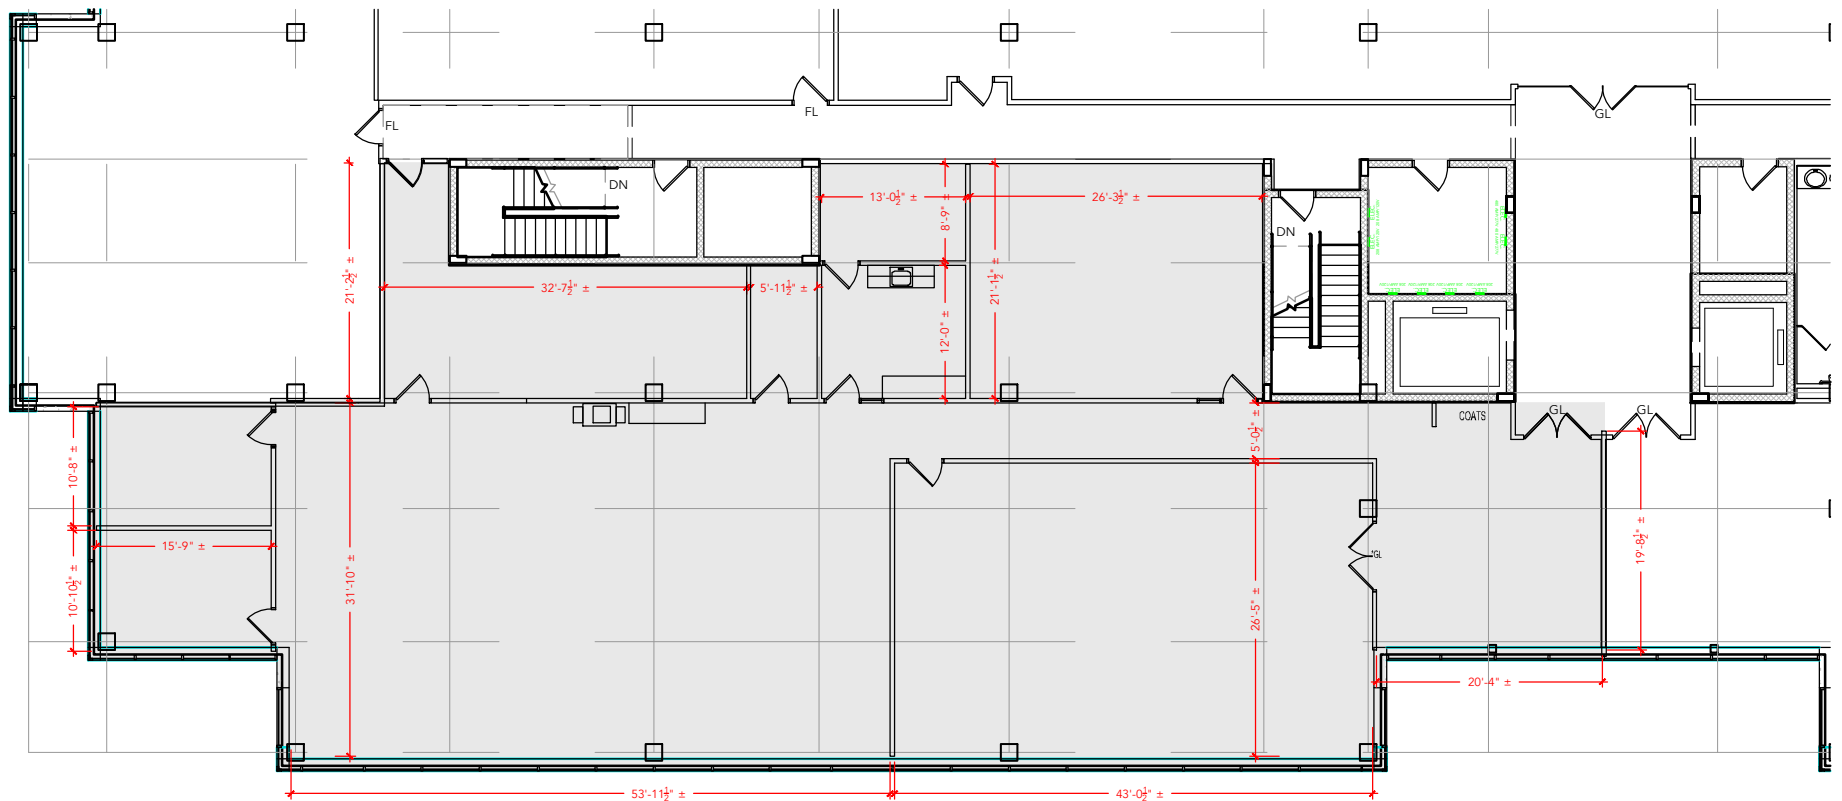

Floor Plan