



TOTAL SF AVAILABLE -1,204 RSF(16%)

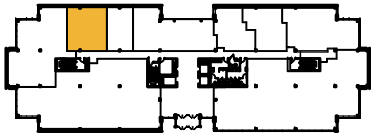

[Click to access 3D model](#)

Key Plan

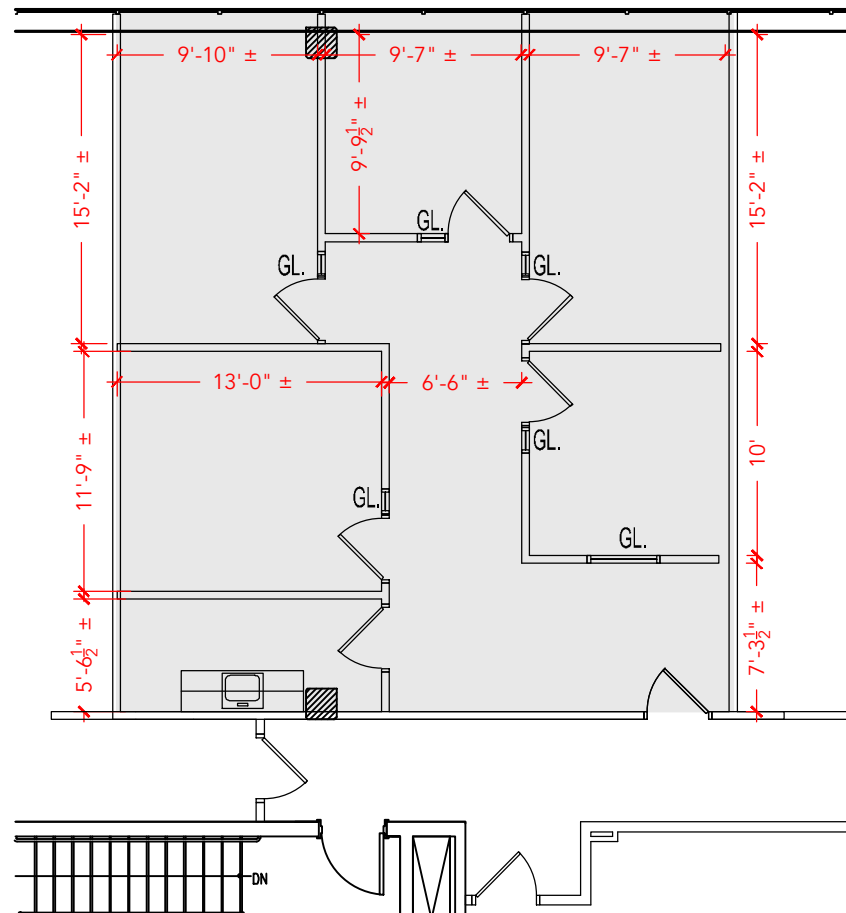

Floor Plan