

CCP 100


6031 UNIVERSITY BLVD ELLICOTT CITY, MD 21043
SUITE 330-355

TOTAL SF AVAILABLE - 10,467 RSF(16%)

Click to access3D model



Key Plan

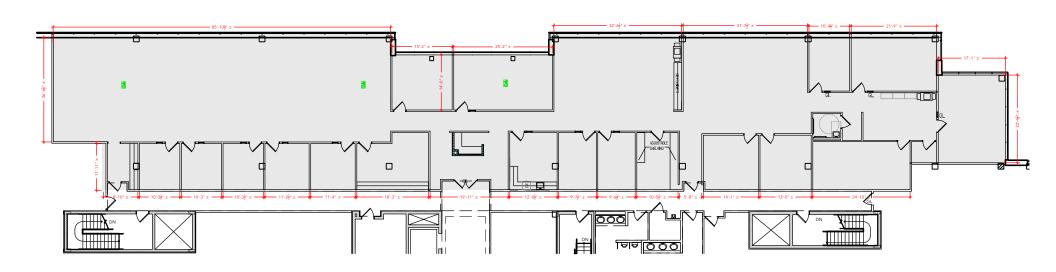

Floor Plan