



TOTAL SF AVAILABLE - 12,350 SF

OFFICE - 1,244 SF
WAREHOUSE - 11,106 SF

[Click to access 3D model](#)

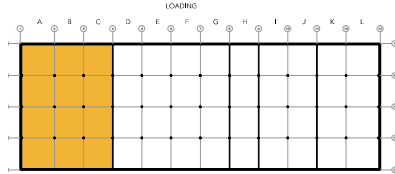

Key Plan

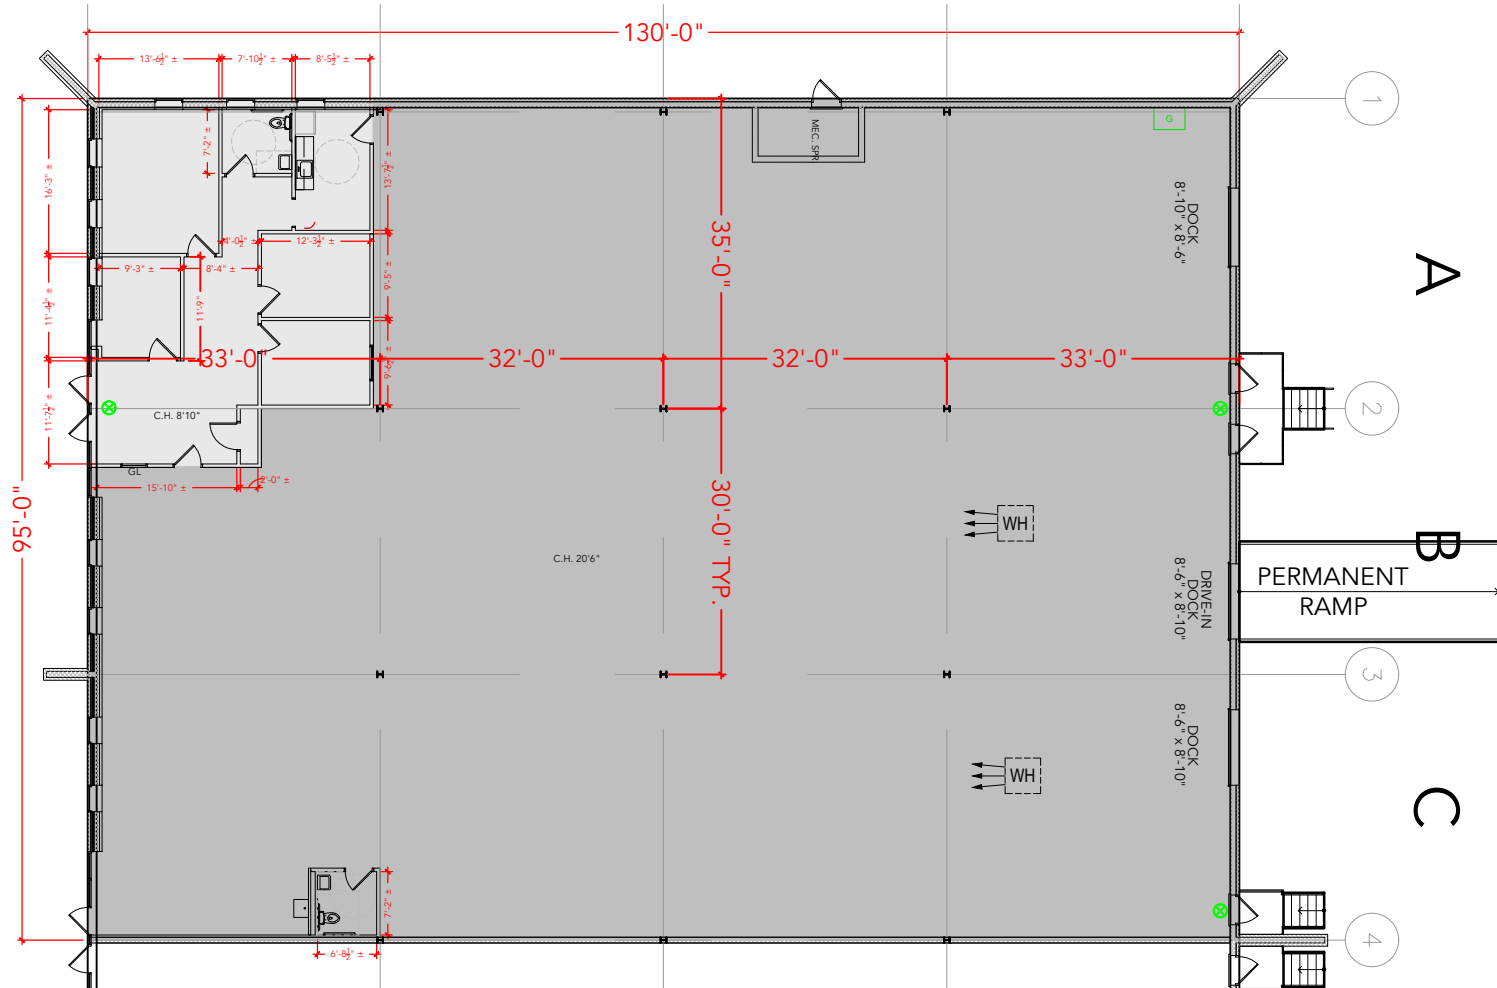

Floor Plan