



**TOTAL SF AVAILABLE -7,200 SF**

OFFICE - 2,551 SF  
WAREHOUSE SF - 4,649 SF

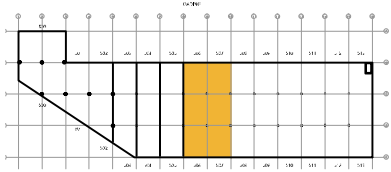

Key Plan

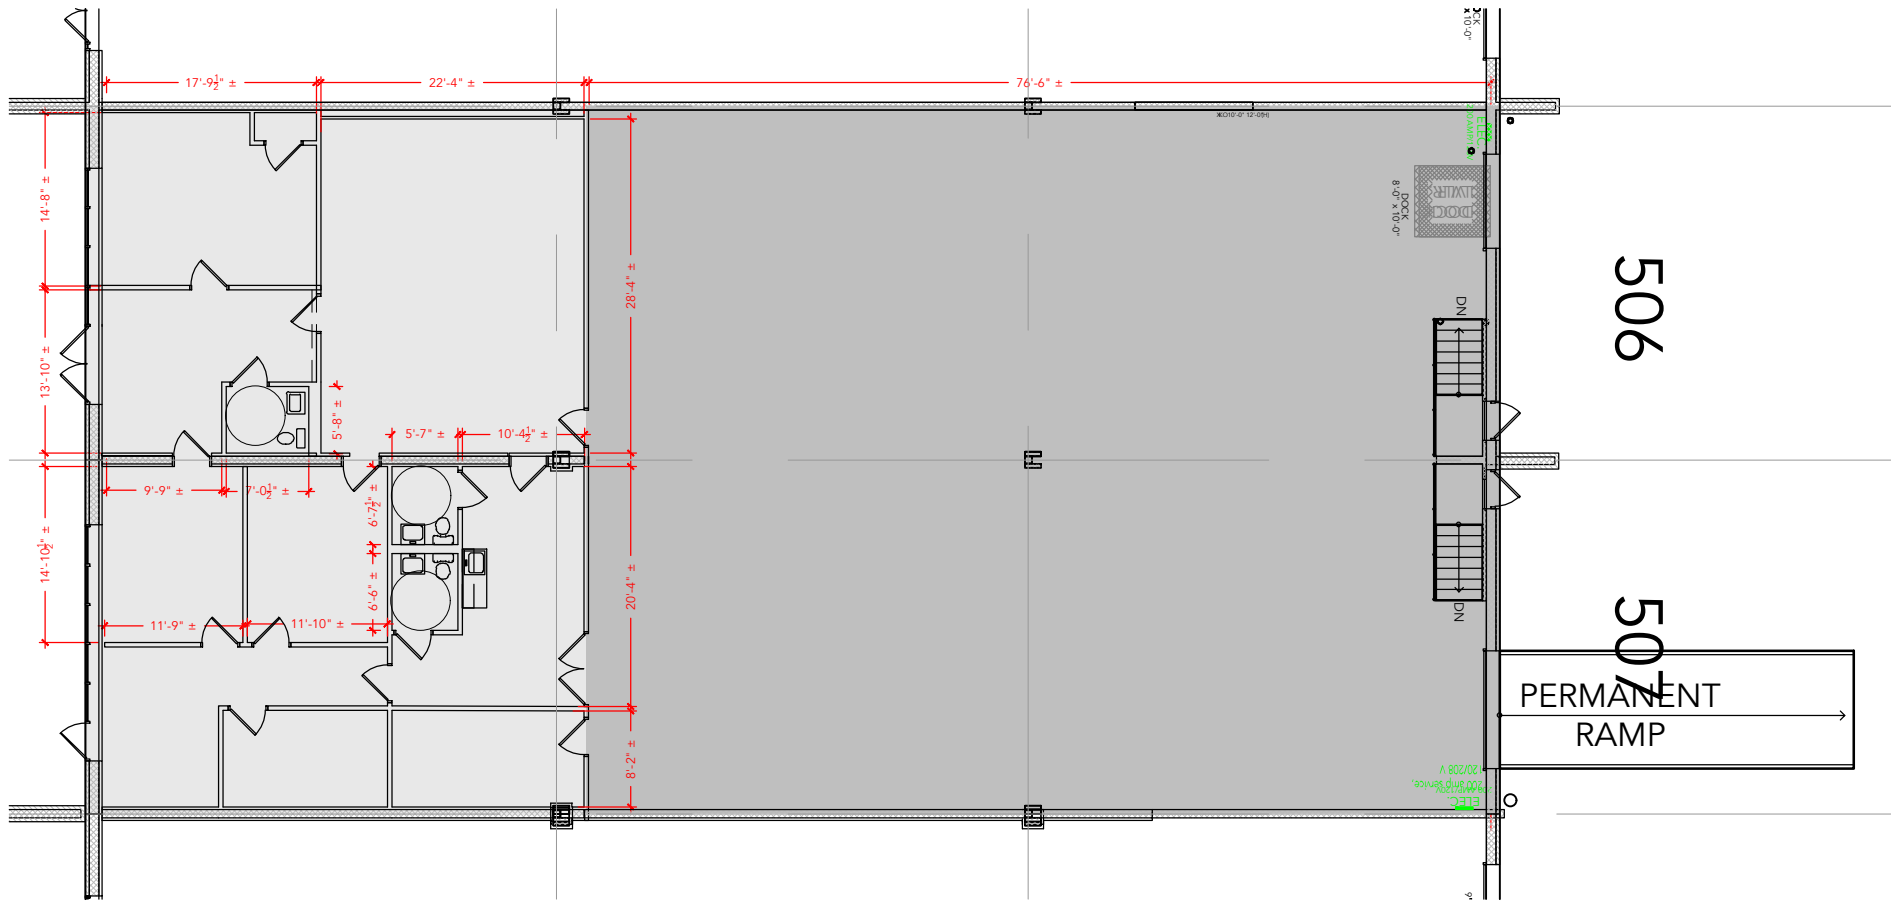

Floor Plan