


TOTAL SF AVAILABLE - 33,629 RSF

OFFICE - 660 RSF

WAREHOUSE - 32,969 RSF



Key Plan

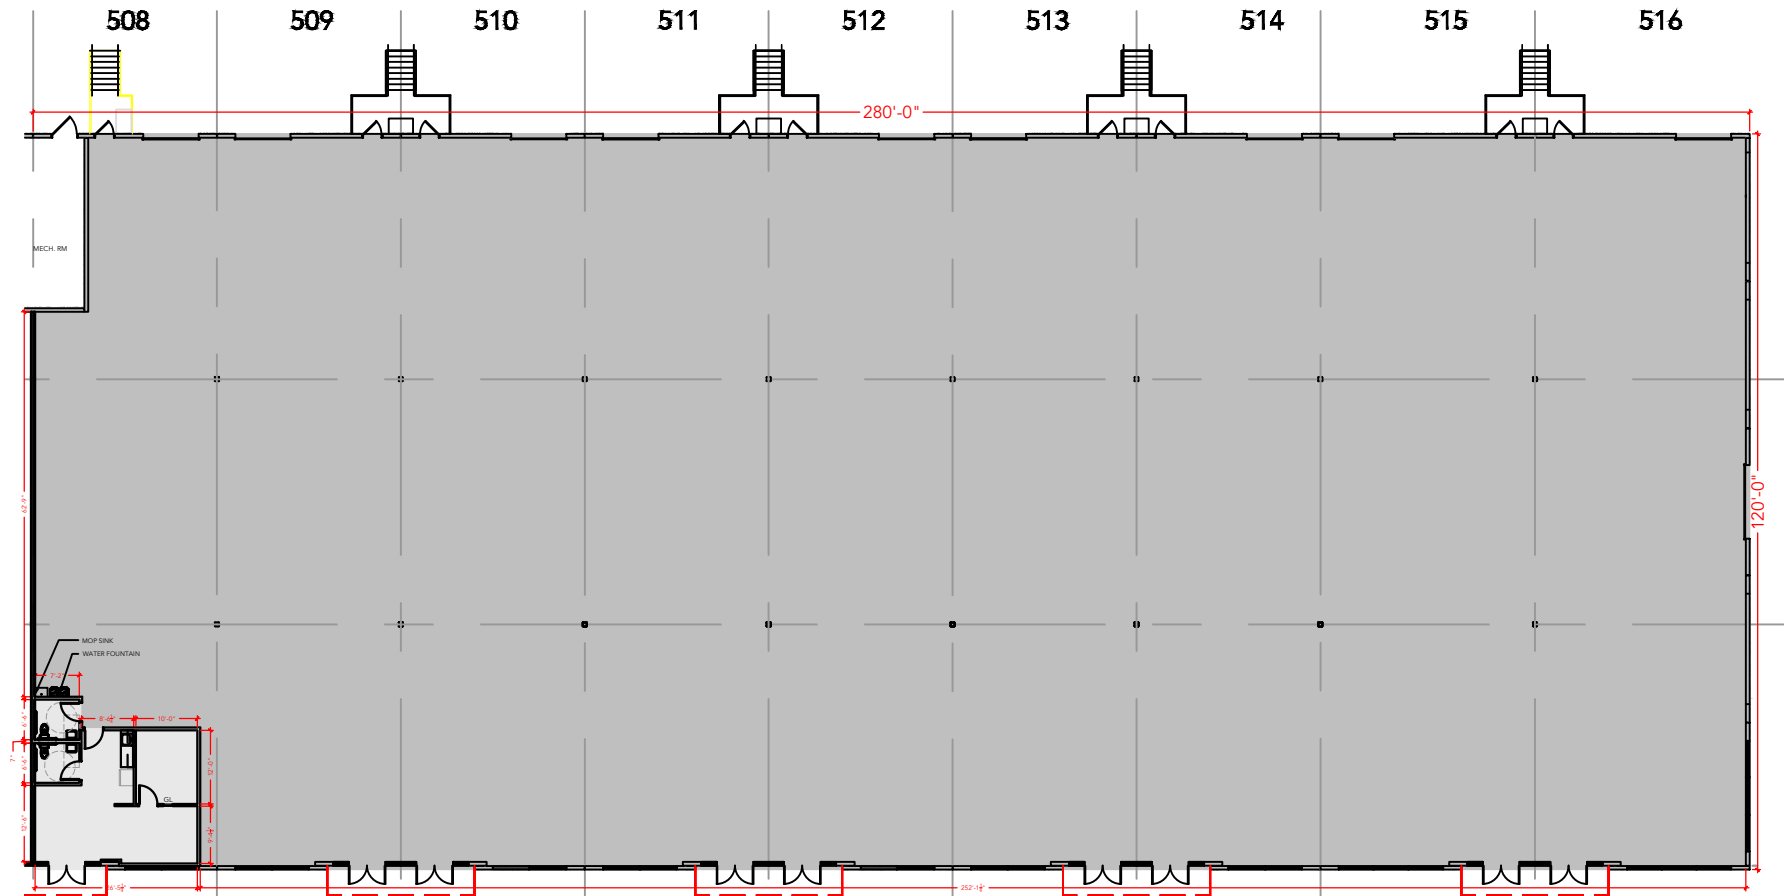

Floor Plan