



TOTAL SF AVAILABLE - 5,635 SF

OFFICE - 3,258 SF

WAREHOUSE - 2,377 SF

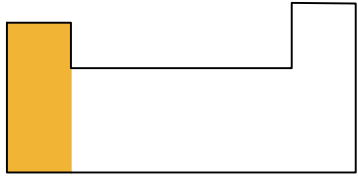

Key Plan

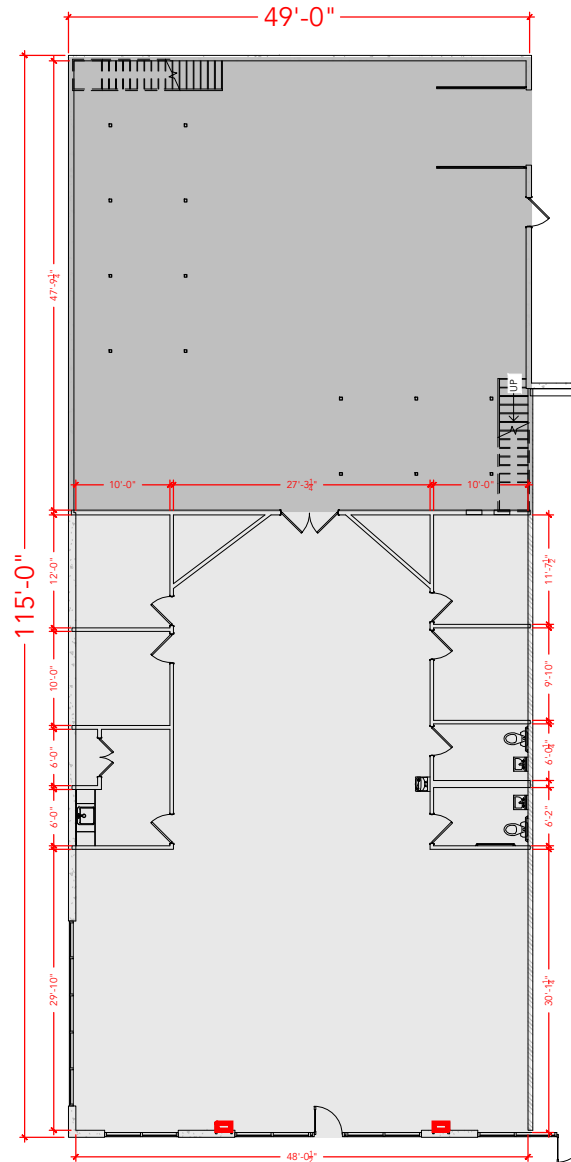

Floor Plan