



**TOTAL SF AVAILABLE - 4,410 SF**

**OFFICE - 2,571 SF**

**WAREHOUSE - 1,839 SF**

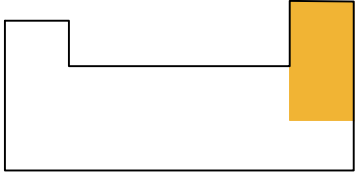

Key Plan

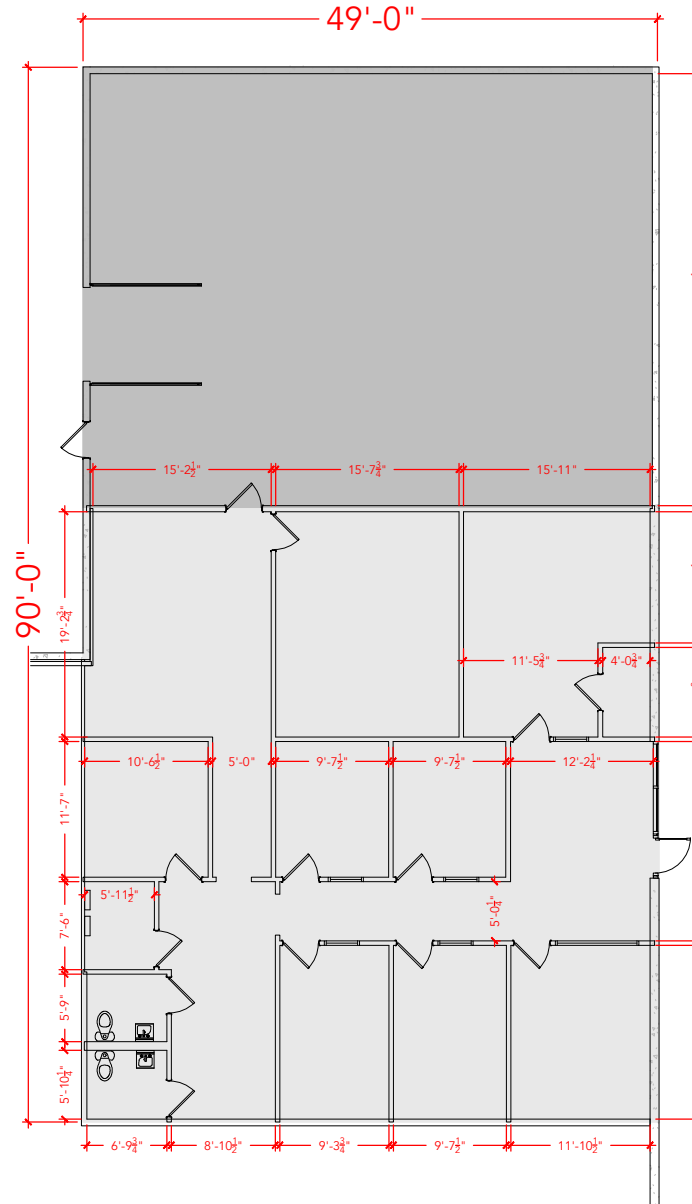

Floor Plan