


**TOTAL SF AVAILABLE - 6,175 RSF**

OFFICE - 272 SF

WAREHOUSE - 5,903 SF



Key Plan

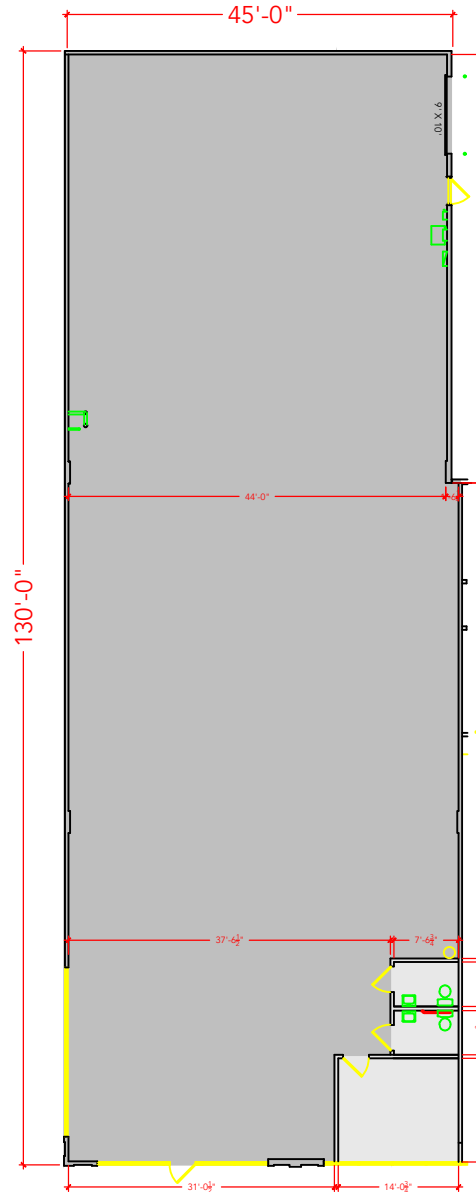

## Floor Plan