



TOTAL SF AVAILABLE - 3,900 SF

OFFICE - 296 SF
WAREHOUSE SF - 3,604 SF

[Click to access 3D model](#)

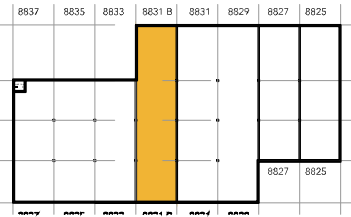

Key Plan

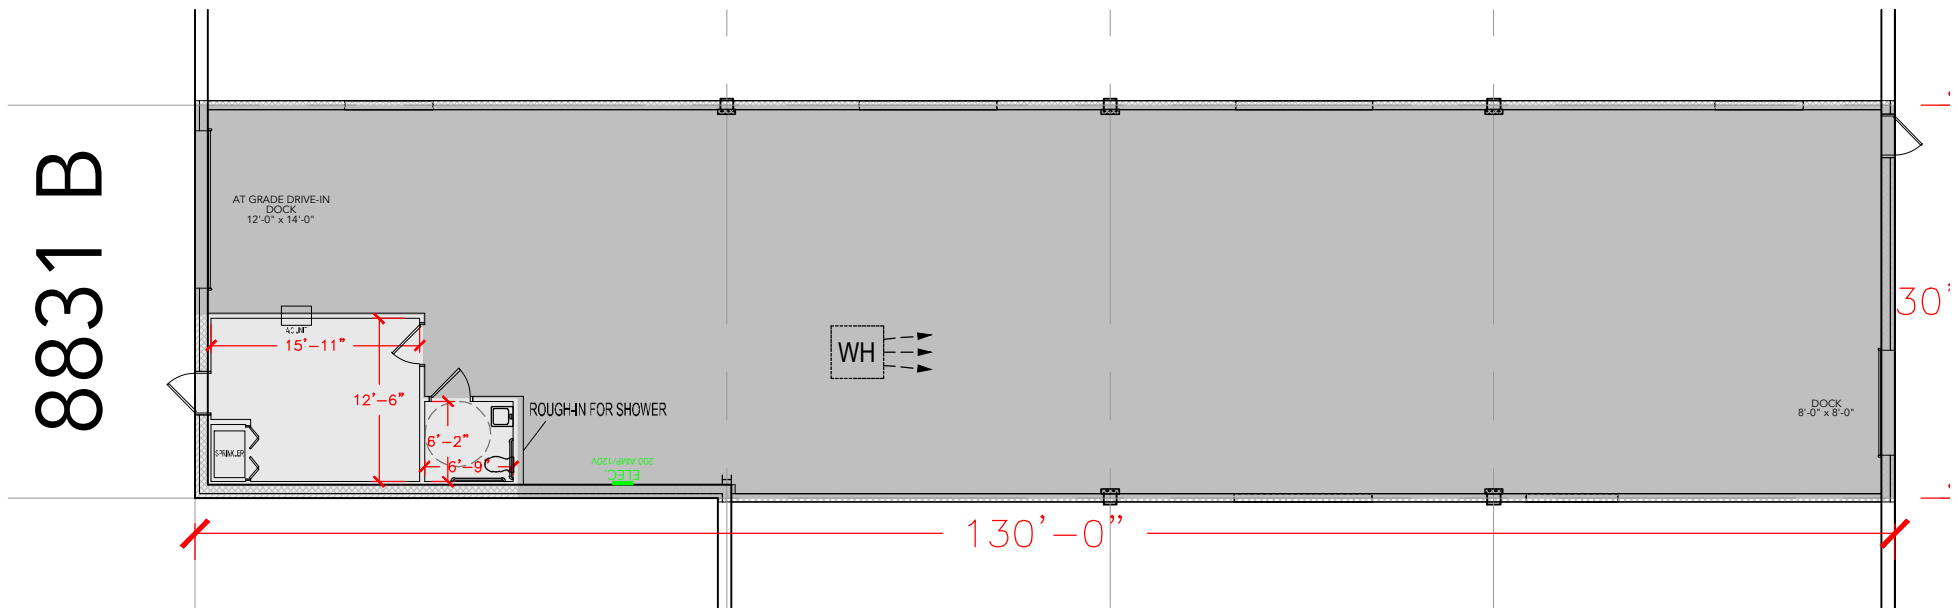

Floor Plan