


TOTAL SF AVAILABLE - 2,250 SF

OFFICE - 528 SF


WAREHOUSE SF - 1,722 SF

[Click to access 3D model](#)

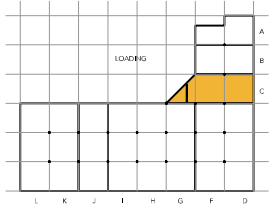

LDING 6

Key Plan

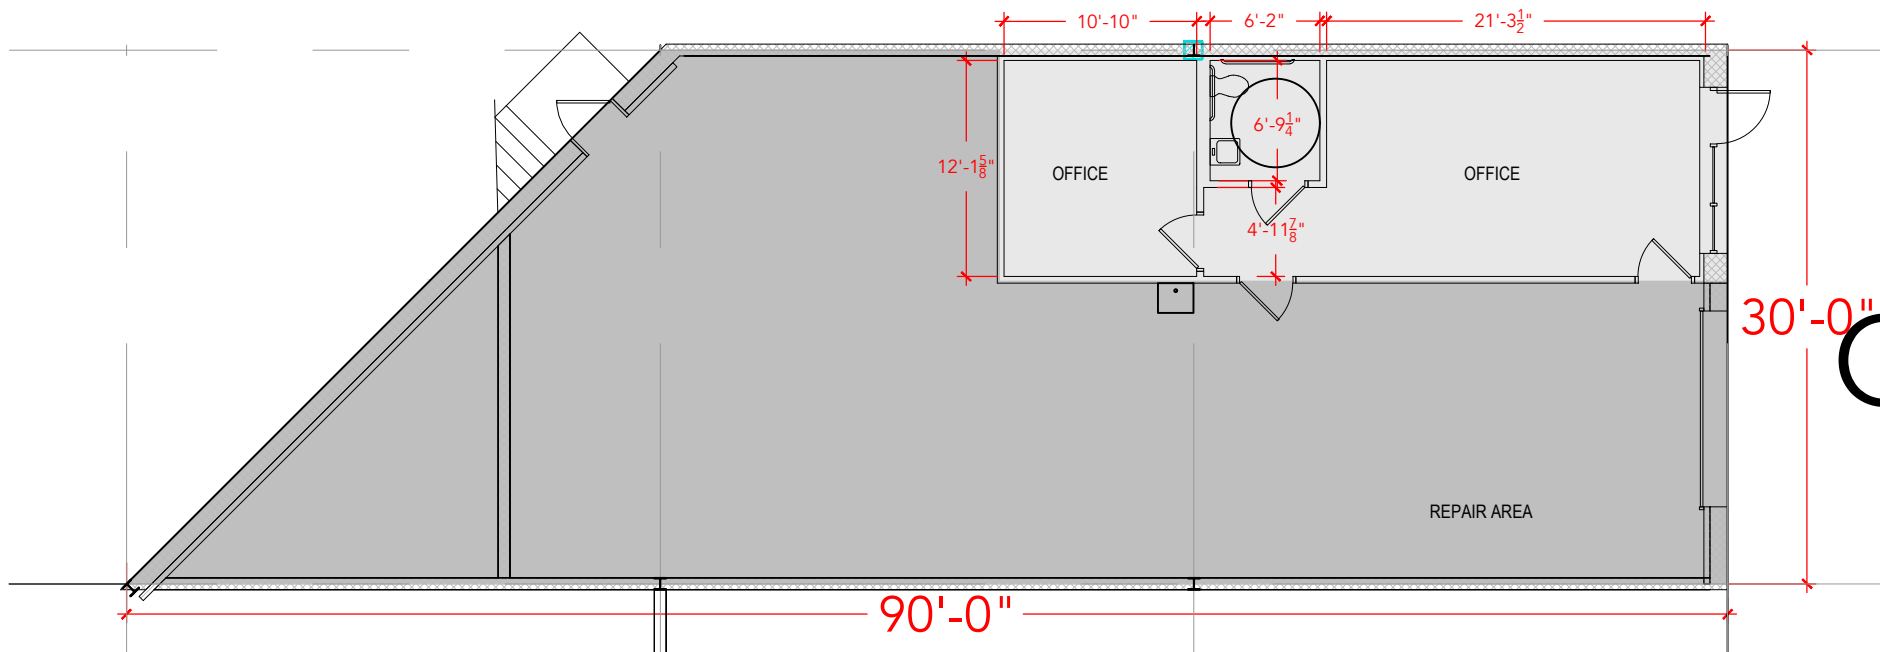

Floor Plan