



**TOTAL SF AVAILABLE -6,667 SF**

OFFICE - 0,000 SF  
WAREHOUSE - 6,667 SF

[Click to access 3D model](#)

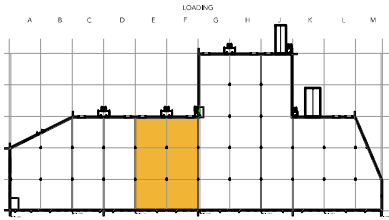

Key Plan

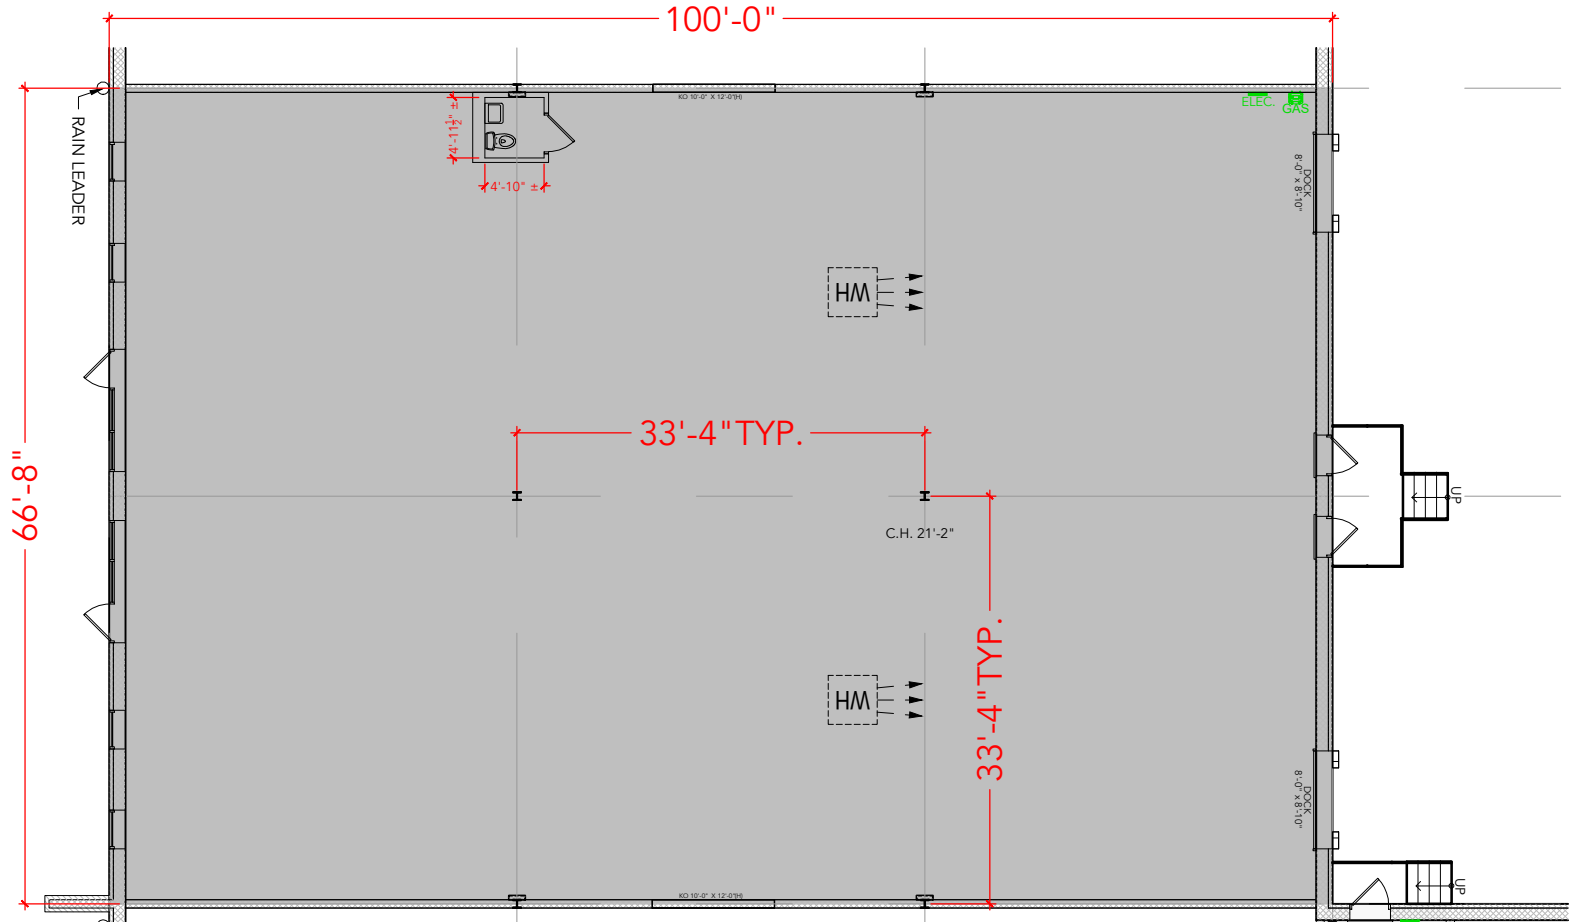

## Floor Plan