


**TOTAL SF AVAILABLE -2,626 RSF**


OFFICE - 2,626 RSF

WAREHOUSE - 0,000 SF

\* INCLUDES % OF METER ROOM  
[Click to access 3D model](#)

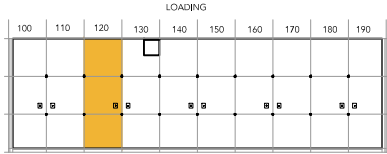

Key Plan

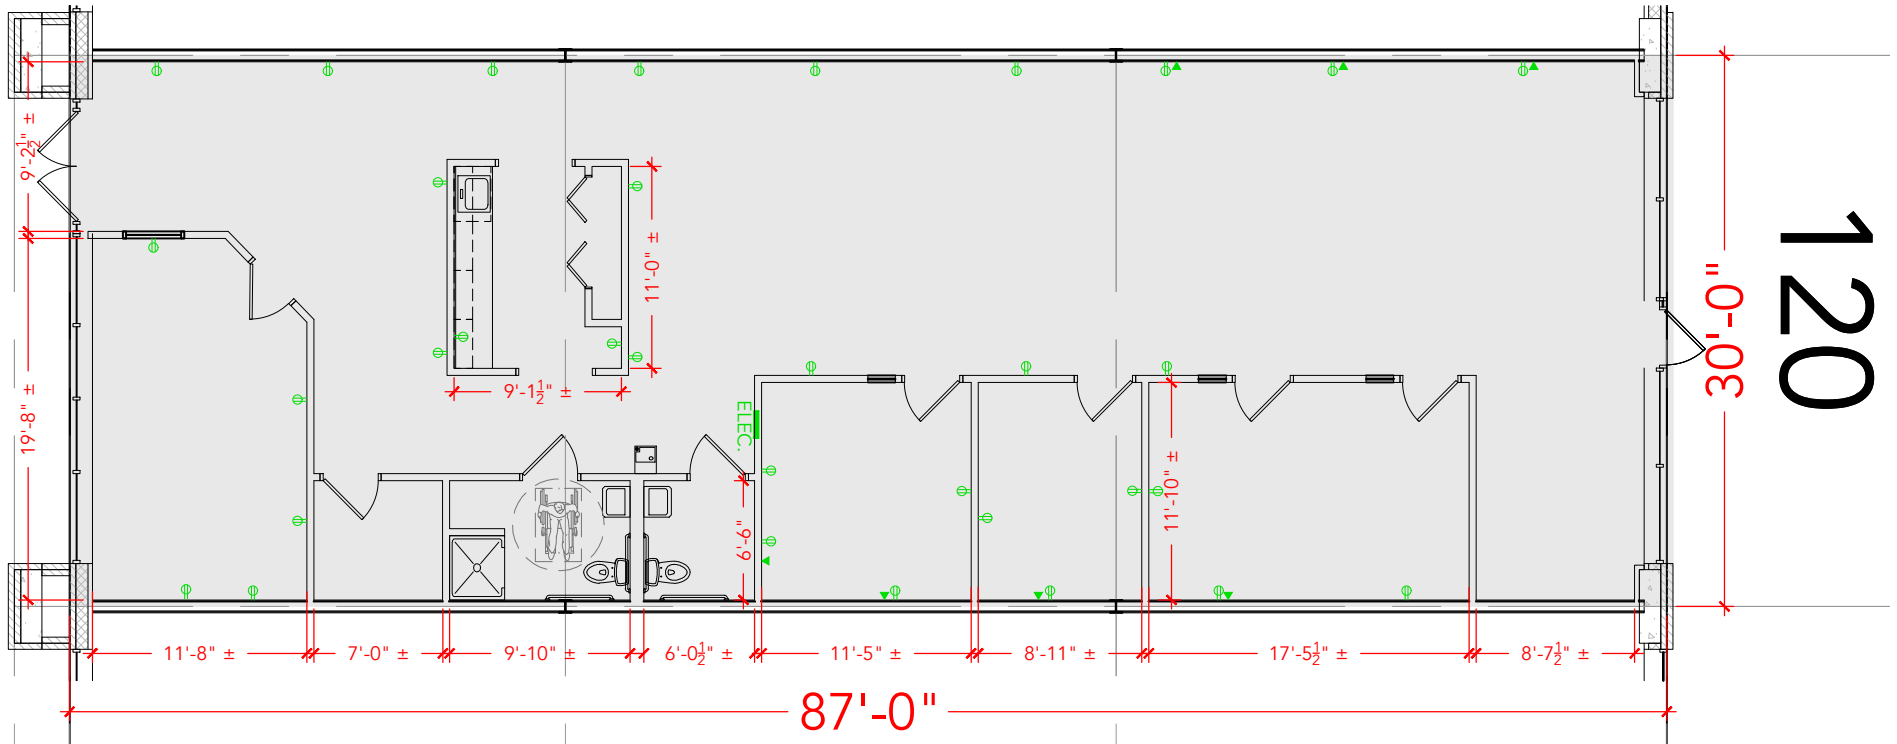

Floor Plan