


**TOTAL SF AVAILABLE - 5,111 RSF**


OFFICE - 5,111 RSF

WAREHOUSE - 0,000 SF

[Click to access 3D model](#)

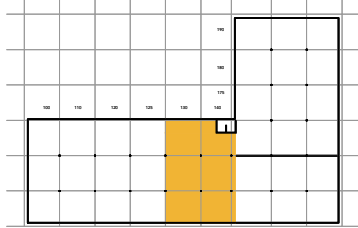

Key Plan

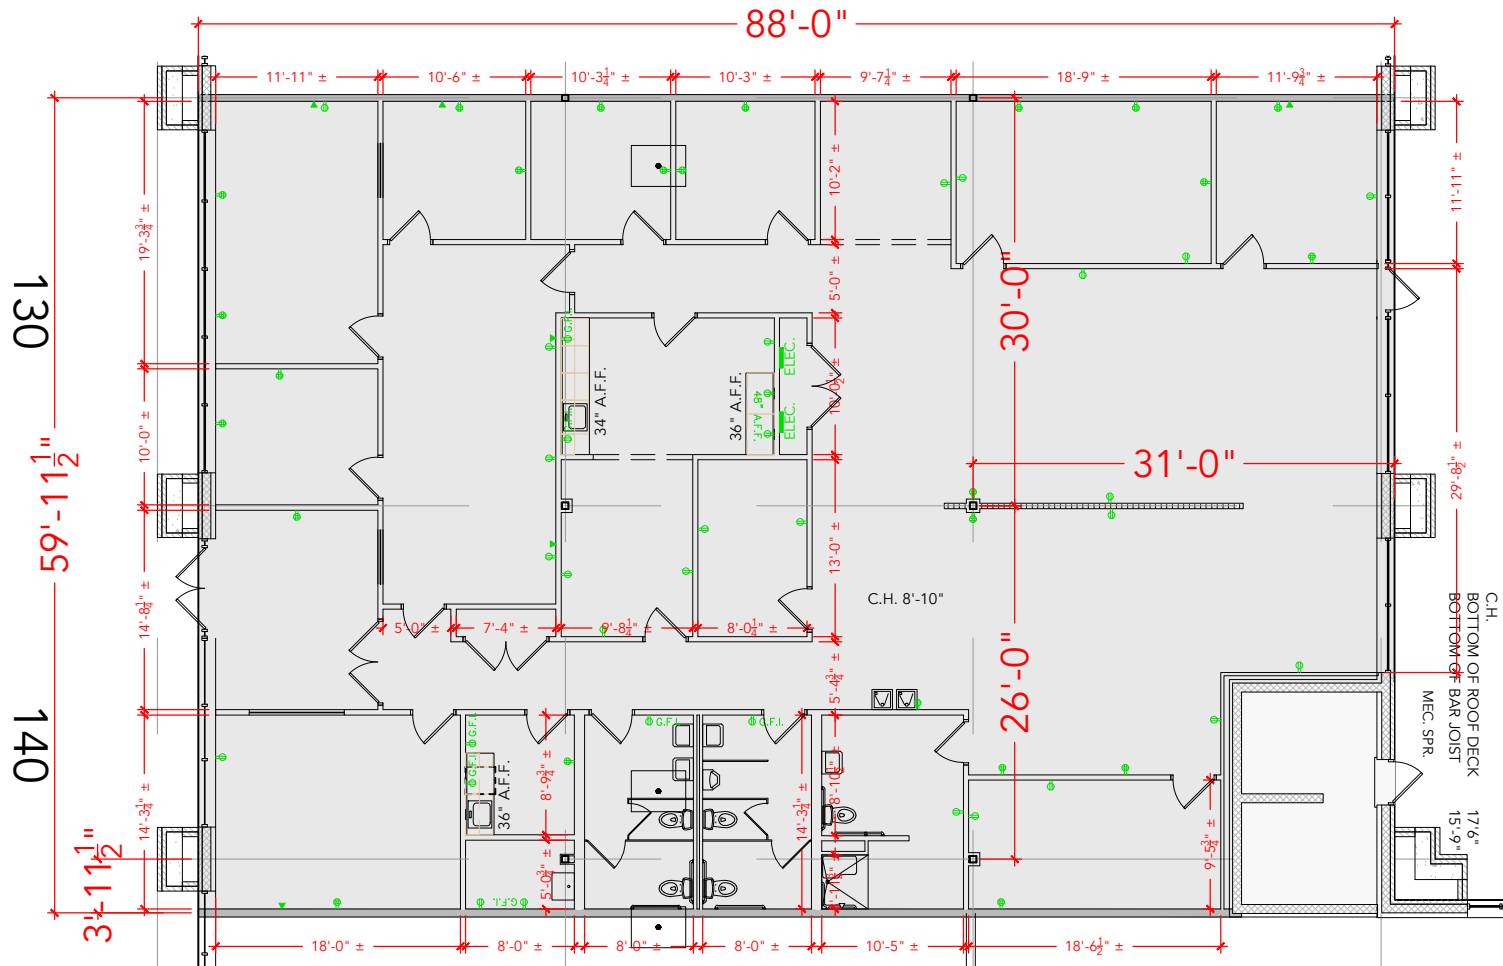

Floor Plan