


TOTAL SF AVAILABLE -12,225 RSF(16%)

[Click to access 3D model](#)



Key Plan

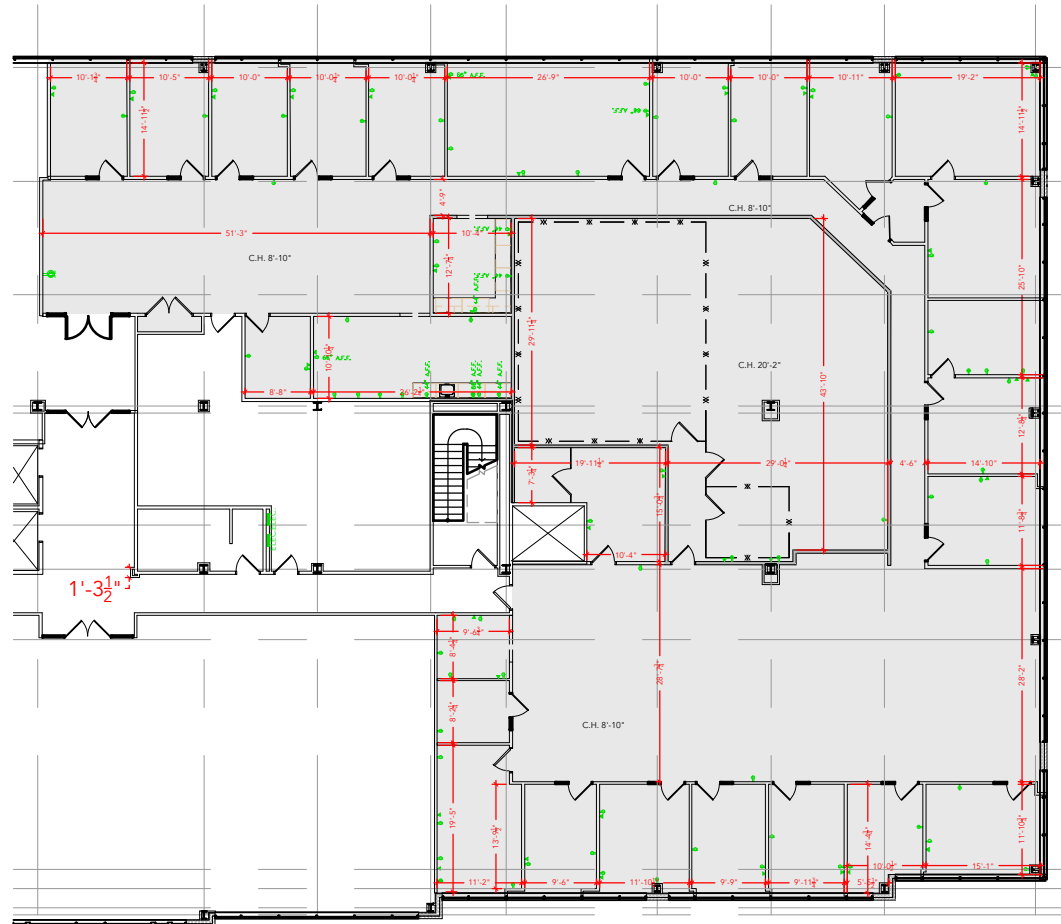

Floor Plan