



TOTAL SF AVAILABLE -53,347 RSF(9%)

[Click to access 3D model](#)

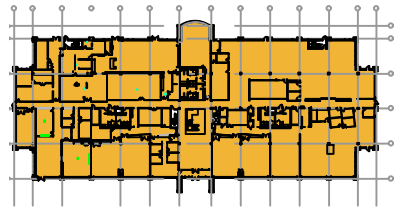

Key Plan

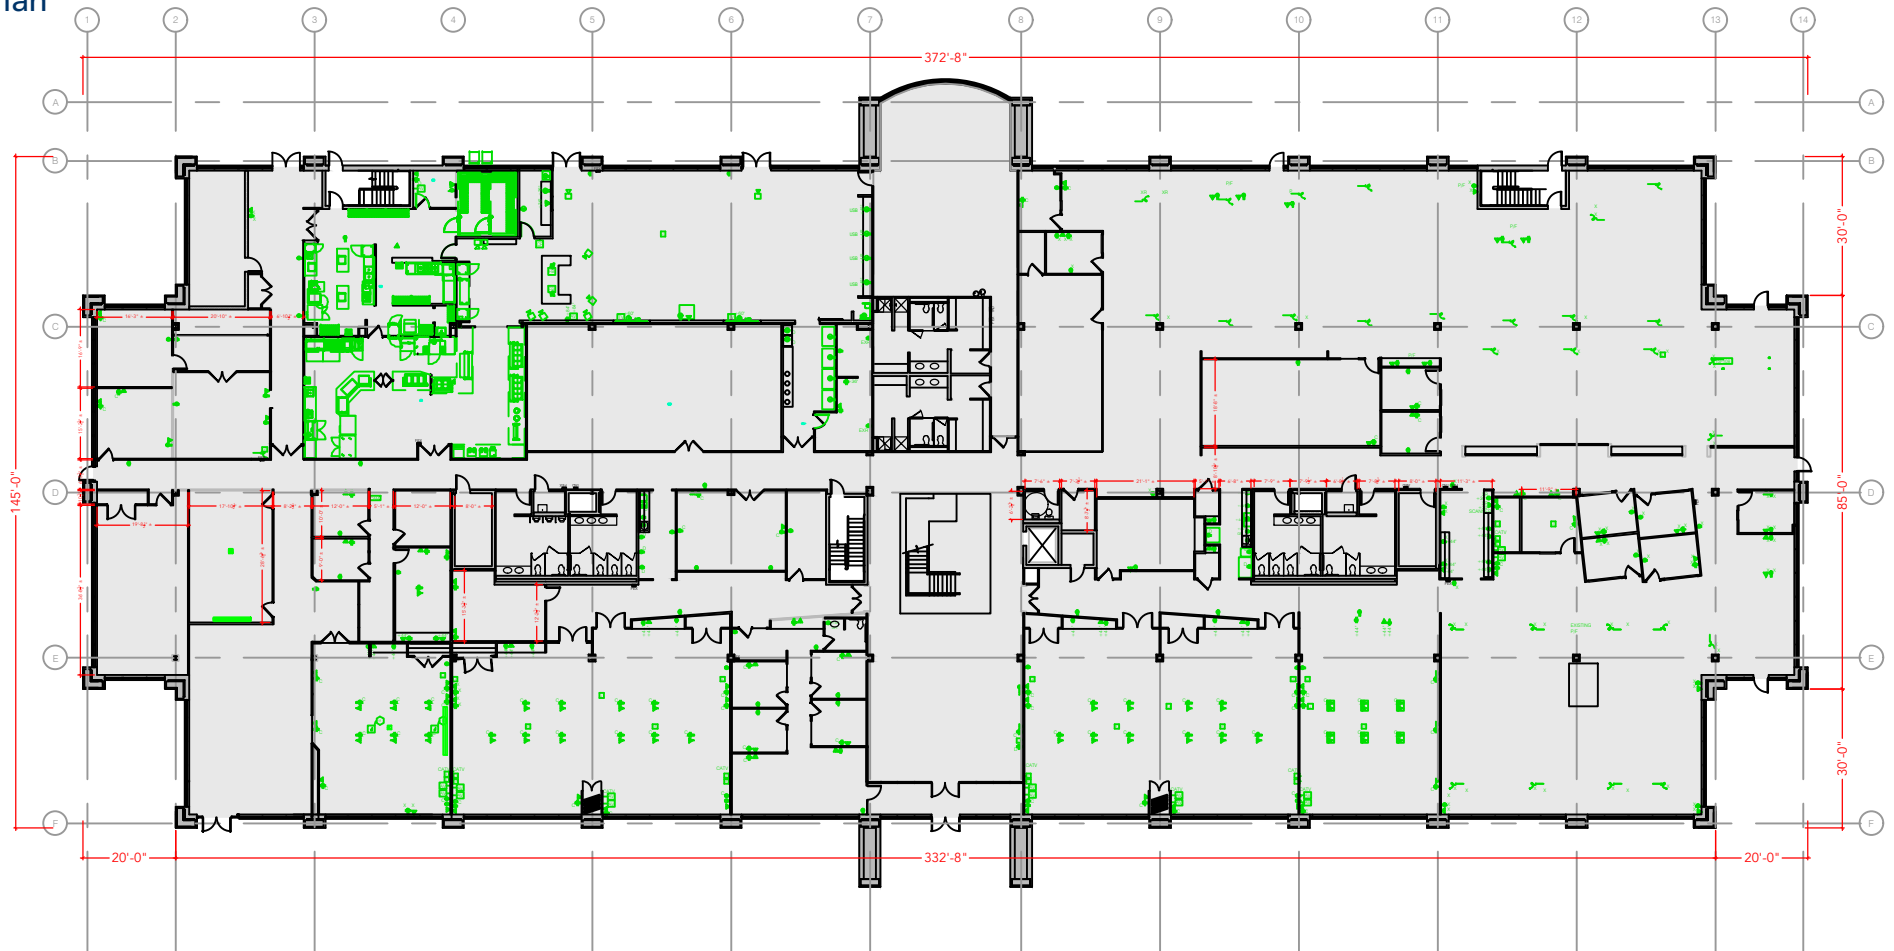

Floor Plan